


# T.15S.R.47 E.W.M.

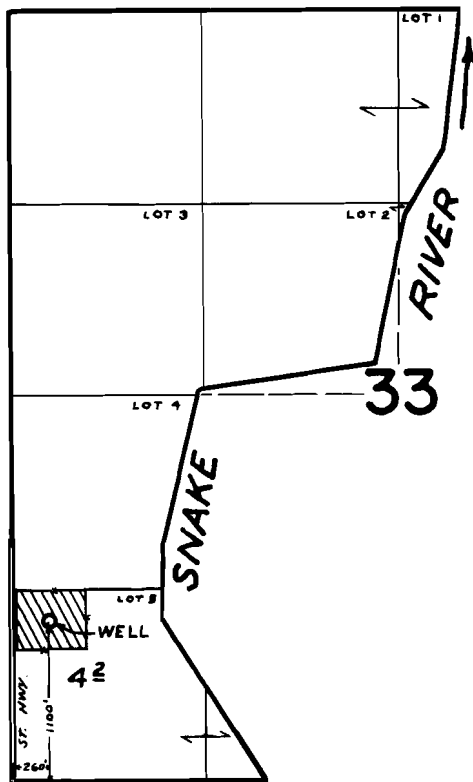

## FINAL PROOF SURVEY UNDER

Application No. G-2884 Permit No. G-2703  
IN NAME OF

Fairview Cemetary Dist.

Surveyed OCT 6 1965, by C. GARDNER