


T. 30 S. R. 46 E. W. M.

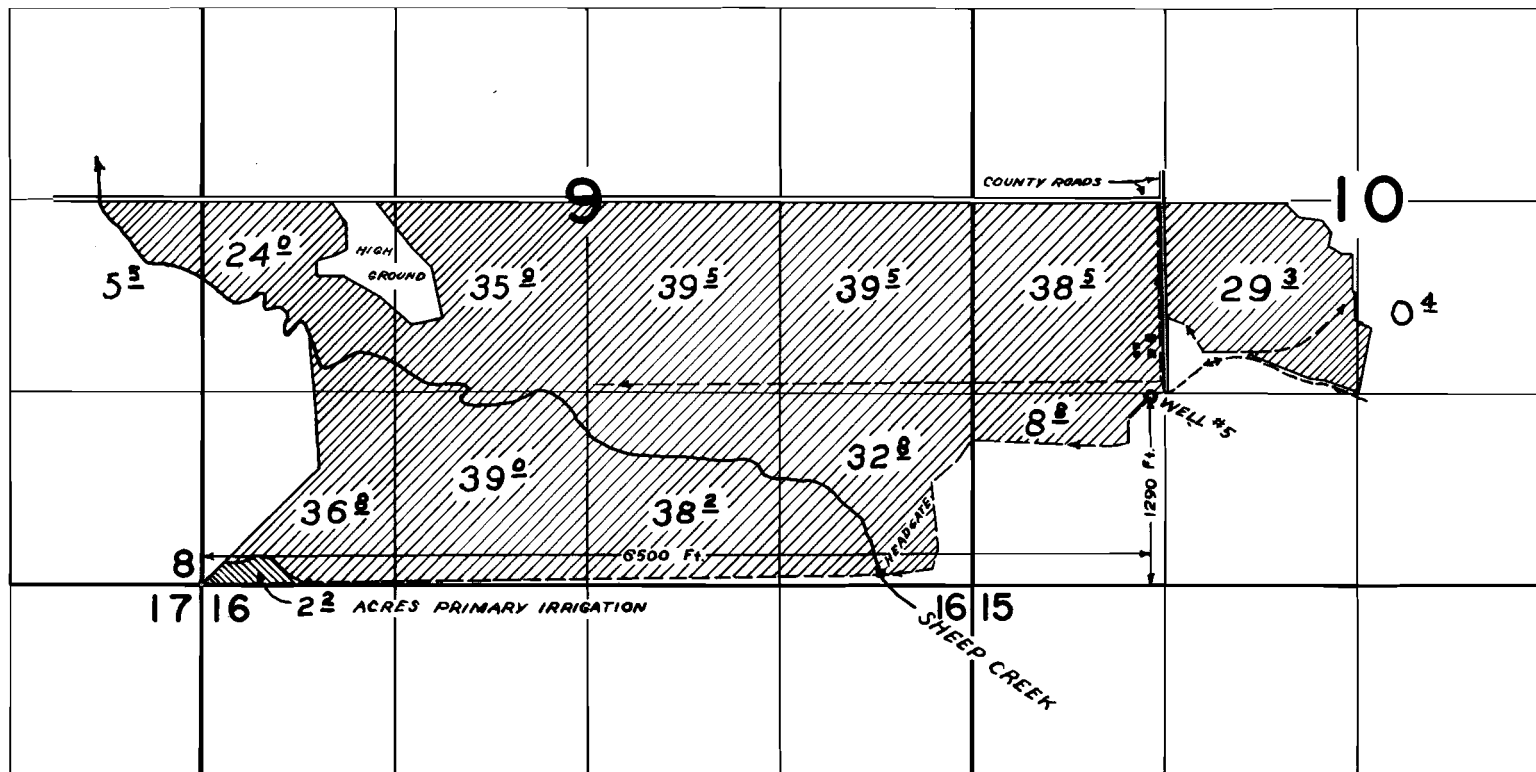

FINAL PROOF SURVEY UNDER

Application No. G-2067 Permit No. G-1905

IN NAME OF

Jaca Brothers

Surveyed OCT. 13, 1965 By C. Gardner