


T.15S.R.47E.W.M.

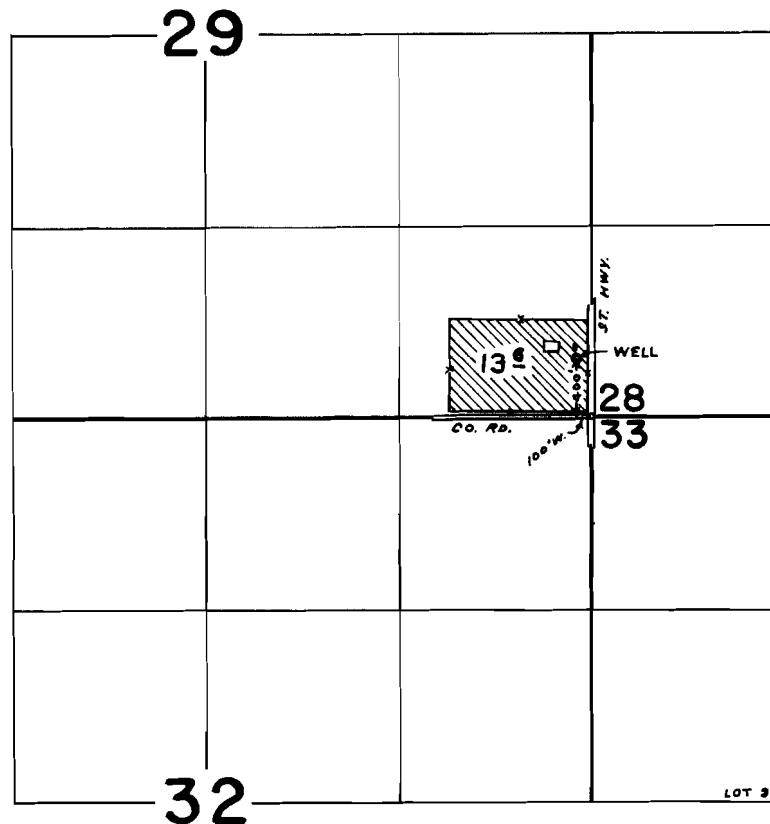

FINAL PROOF SURVEY
UNDER

Application No. G-2943 Permit No. G-2737
IN NAME OF

George Weitzel

Surveyed Oct. 6, 1965, by C. GARDNER