


T.8&9S.R.3W.W.M.

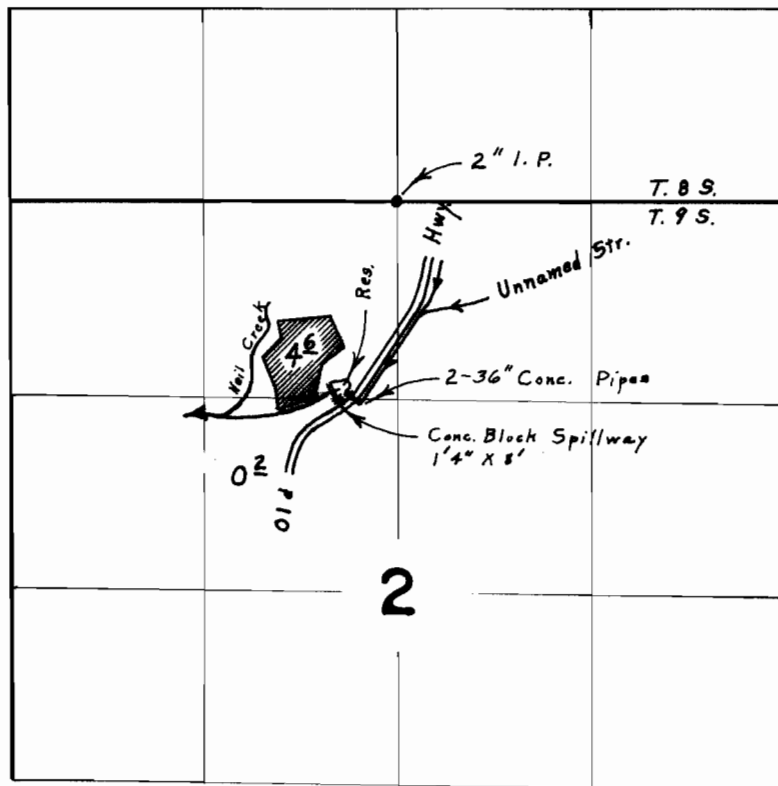

Div. Pt. Located 1310' S. & 440' W. From The N. $\frac{1}{4}$ Cor. Sec. 2

FINAL PROOF SURVEY
UNDER

R-38991 R-3523
Application No. 38992 Permit No. 29006
IN NAME OF
RONALD WILLIAM BELL

Surveyed Sept. 9, 1966, by L. E. Gould