


T. 7 S. R. 1 W. W. M.

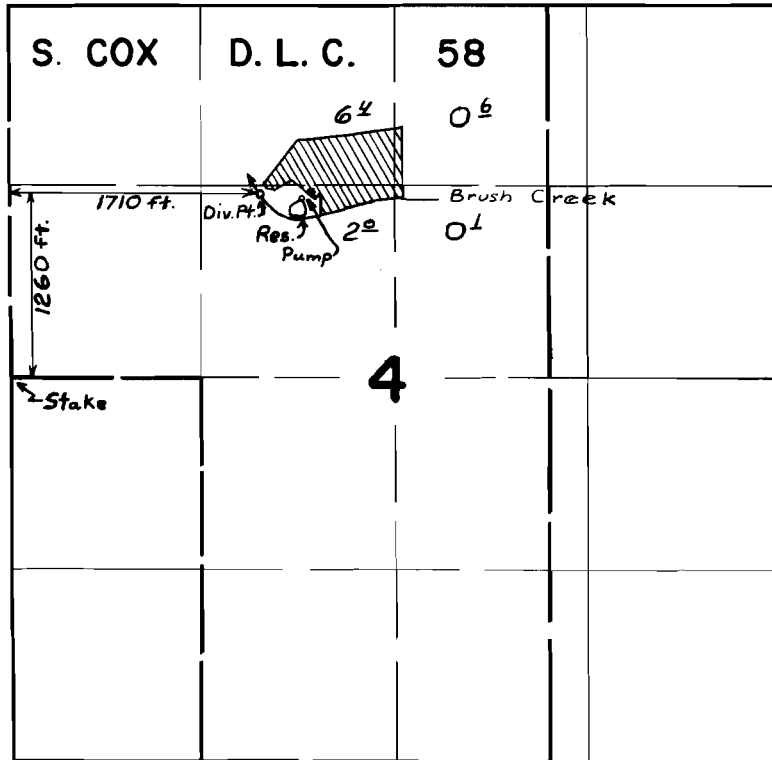

FINAL PROOF SURVEY UNDER

R-38380 R-3210
Application No. 38381 Permit No. 28602
IN NAME OF

TOM BENSON

Surveyed March 12, 1967, by W. J. Ruppert