


# T. 7 S. R. 1 W. W. M.

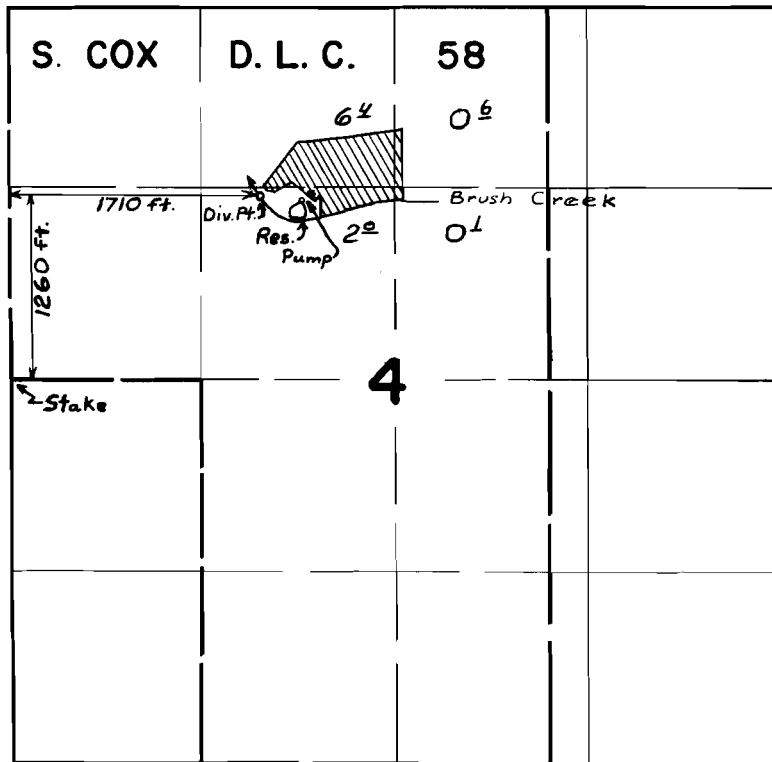

## FINAL PROOF SURVEY UNDER

R-38380                      R-3210  
 Application No. 38381      Permit No. 28602  
 IN NAME OF

**TOM BENSON**

Surveyed March 12, 1967, by W. J. Ruppert