


T.6S.R.3 W.W.M.

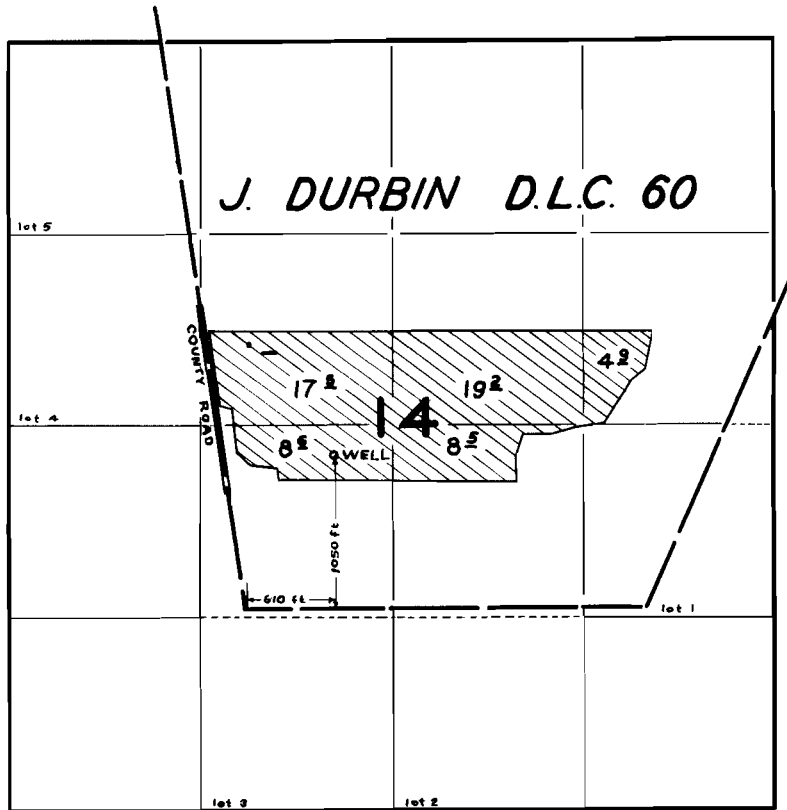

FINAL PROOF SURVEY
UNDER

Application No. G-3035 Permit No. G-2821
IN NAME OF

WALTER R. & HELEN G. COLLETT

Surveyed JUL. 9 1965, by L. COLEBANK