


T. 8 S. R. 4 W. W.M.

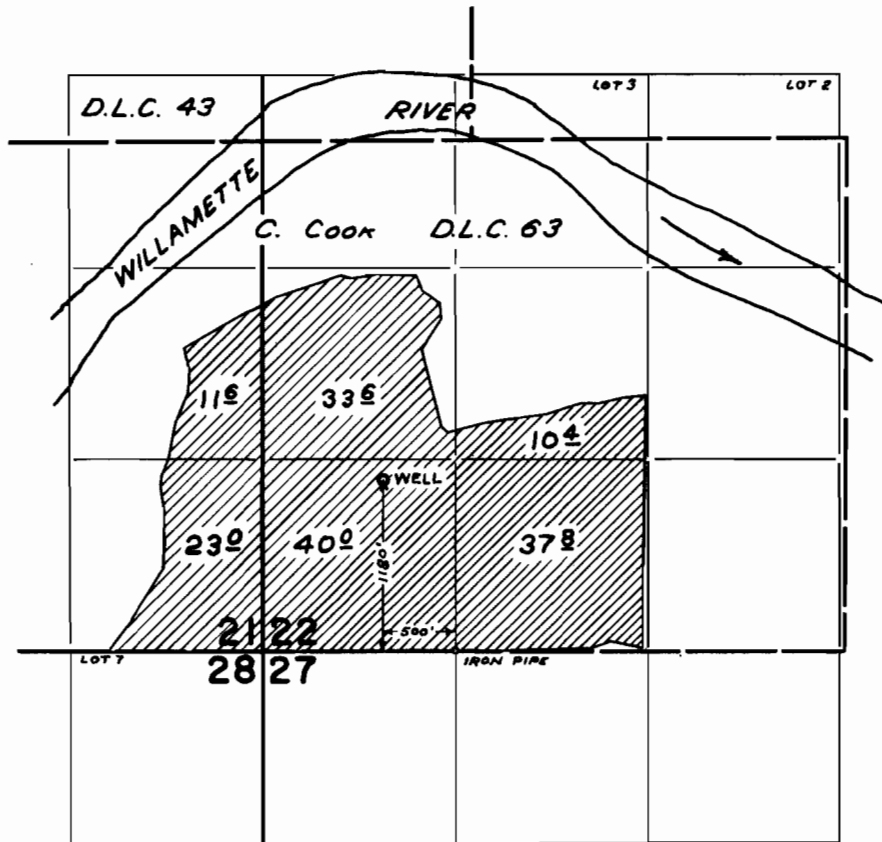

FINAL PROOF SURVEY UNDER

Application No. G-2627 Permit No. G-2434
IN NAME OF

Four D Farms

Surveyed JUN. 17 1965, by C. GARDNER