


T. 7 S. R. 1 E. W. M.

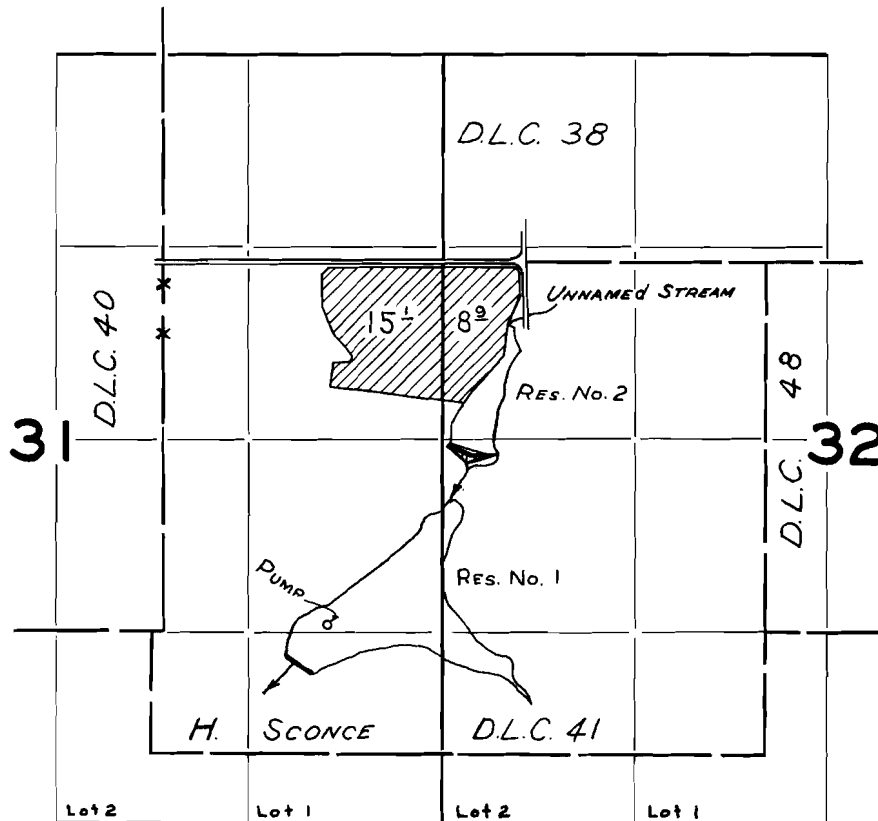

FINAL PROOF SURVEY
UNDER

Application No. R-30673
30674 Permit No. R-1852
24152
IN NAME OF

FLOYD T. FOX

Surveyed JUL 16 1964, by R. JACKSON