


T. 7 S. R. 1 E. W. M.

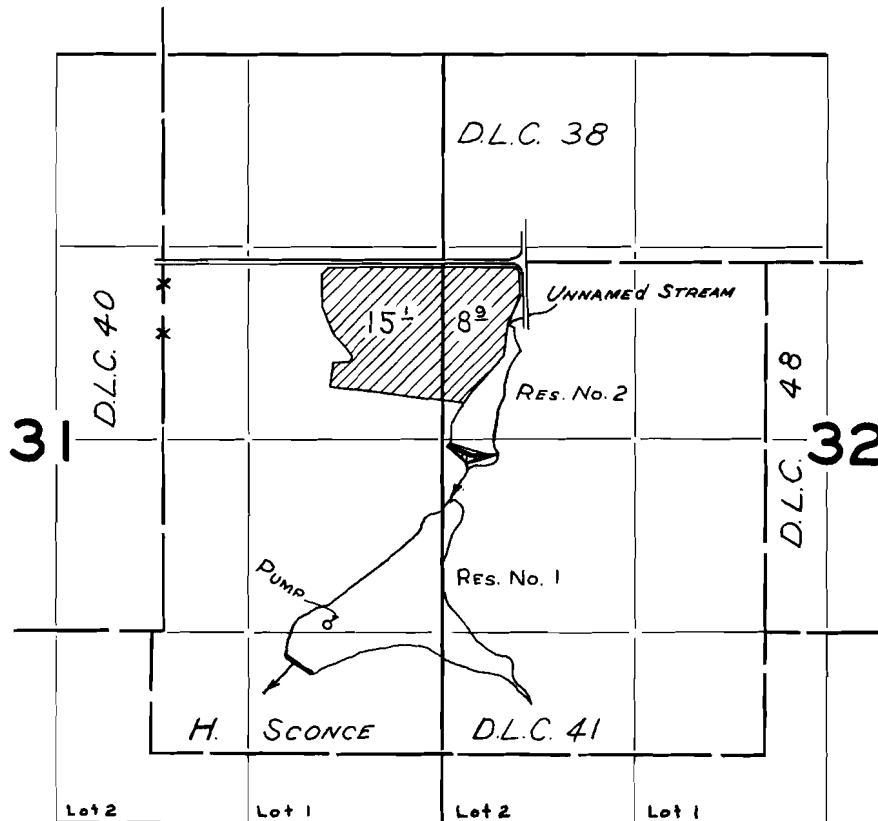

**FINAL PROOF SURVEY**  
UNDER

Application No. R-30673  
30674 Permit No. R-1852  
24152  
IN NAME OF

FLOYD T. FOX

Surveyed JUL 16 1964, by R. JACKSON