


T.5S.R.1W.W.M.

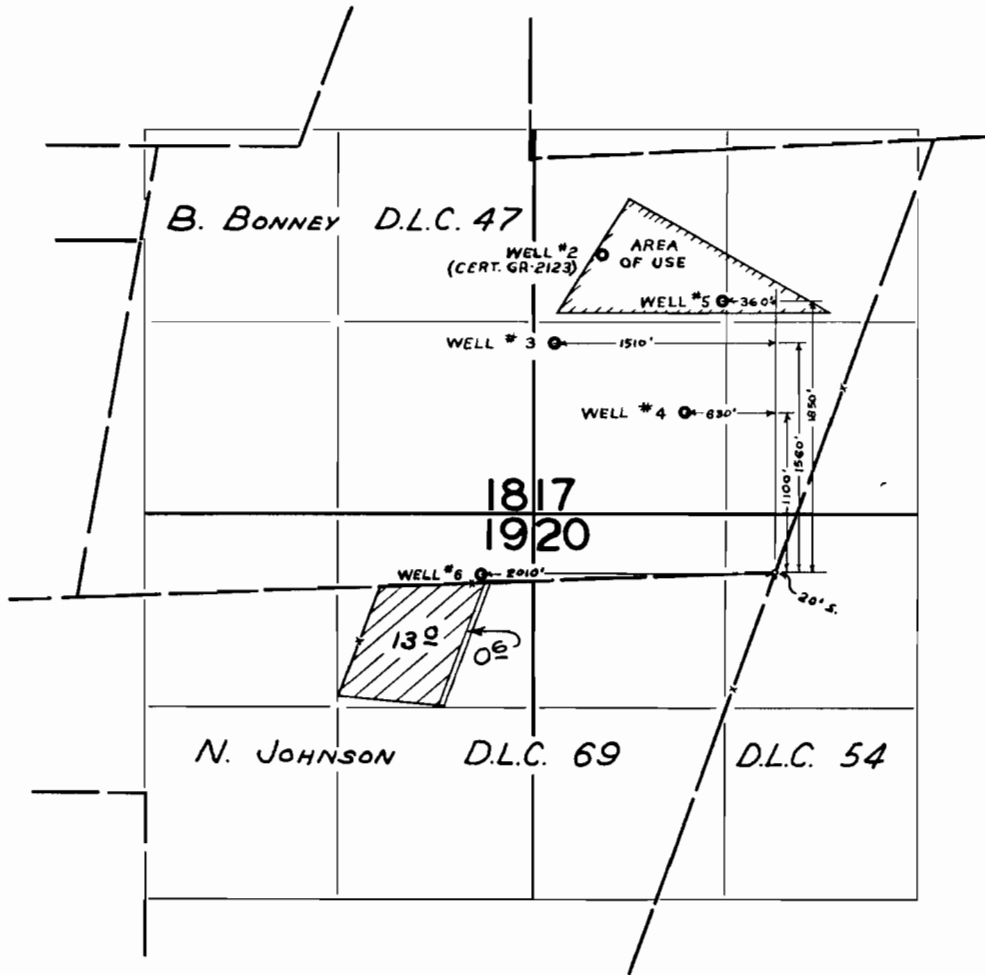

FINAL PROOF SURVEY UNDER

Application No. G-2131 Permit No. G-1968
G-2532 G-2324
G-2805 G-2723

IN NAME OF

GENERAL FOODS CORPORATION

Surveyed APR. 13 1965, by C. GARDNER