


T.5 S.R. I.W.W.M.

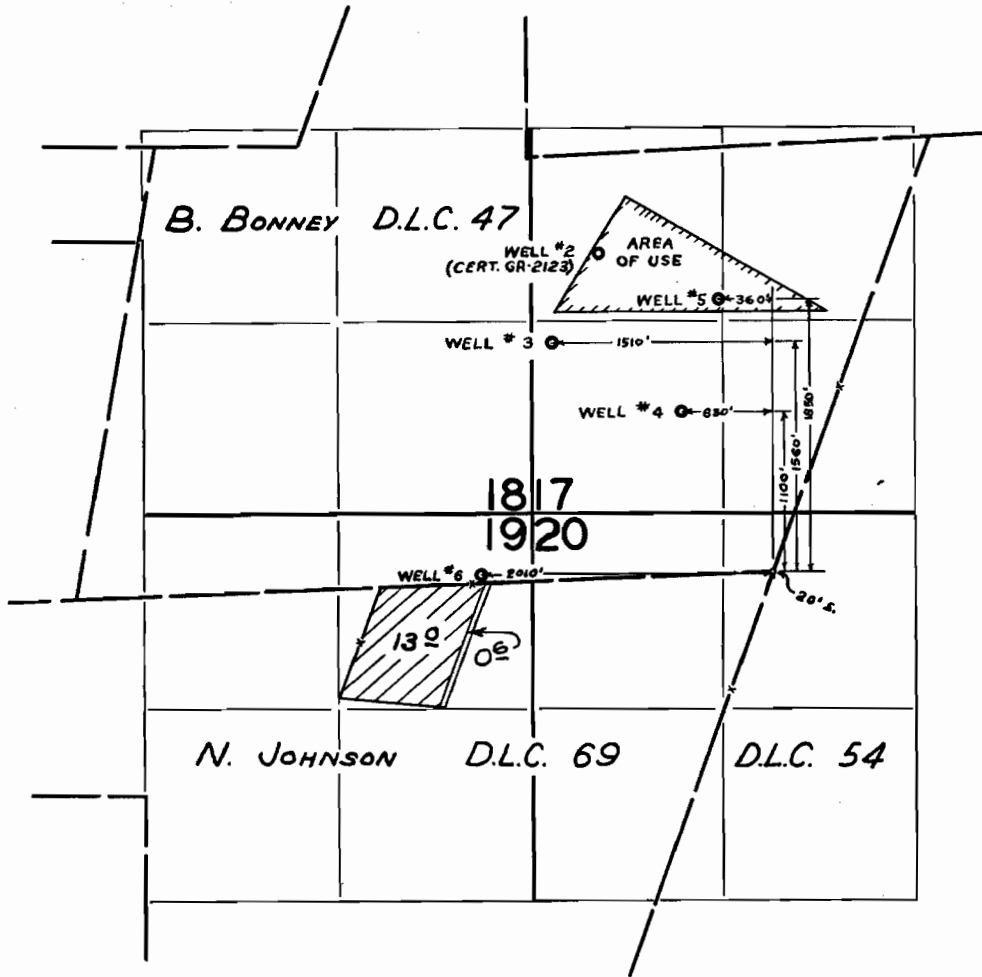

FINAL PROOF SURVEY UNDER

Application No. G-2131
G-2532
G-2805 Permit No. G-1968
G-2324
G-2723 Cert No. 33969
33970
33971

IN NAME OF

GENERAL FOODS CORPORATION

Surveyed APR. 13 1965, by C. GARDNER