


# T.6S.R.2W.W.M.

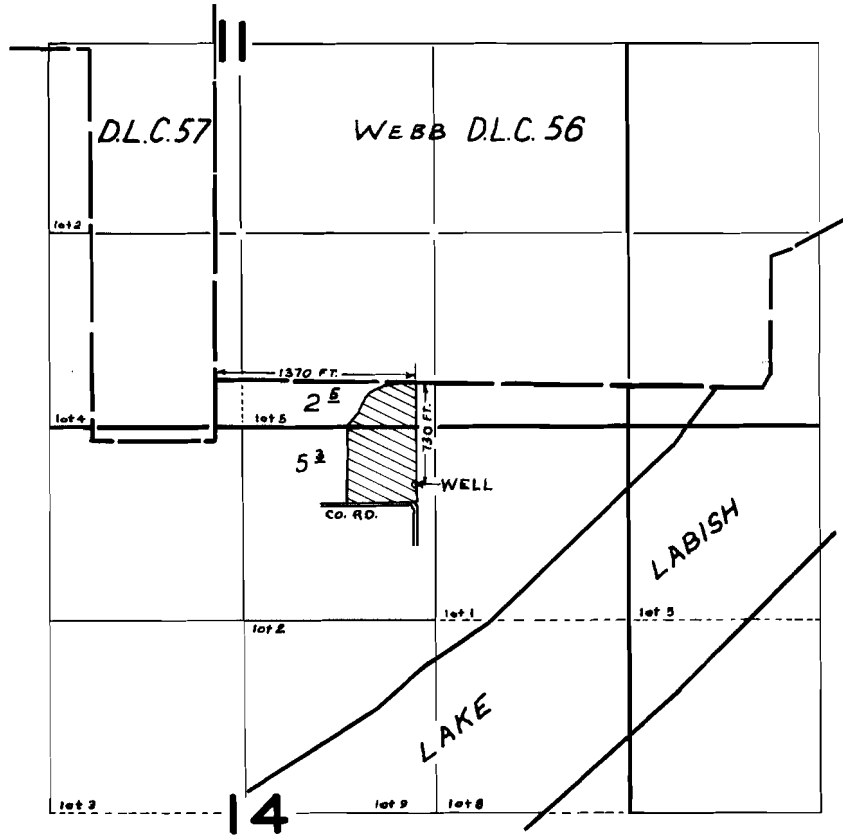

## FINAL PROOF SURVEY UNDER

Application No. G-2827 Permit No. G-2630  
IN NAME OF

SIDNEY R. JOHNSON

Surveyed JUL. 9 1965, by L. COLEBANK