


T.5S.R.2W.W.M.

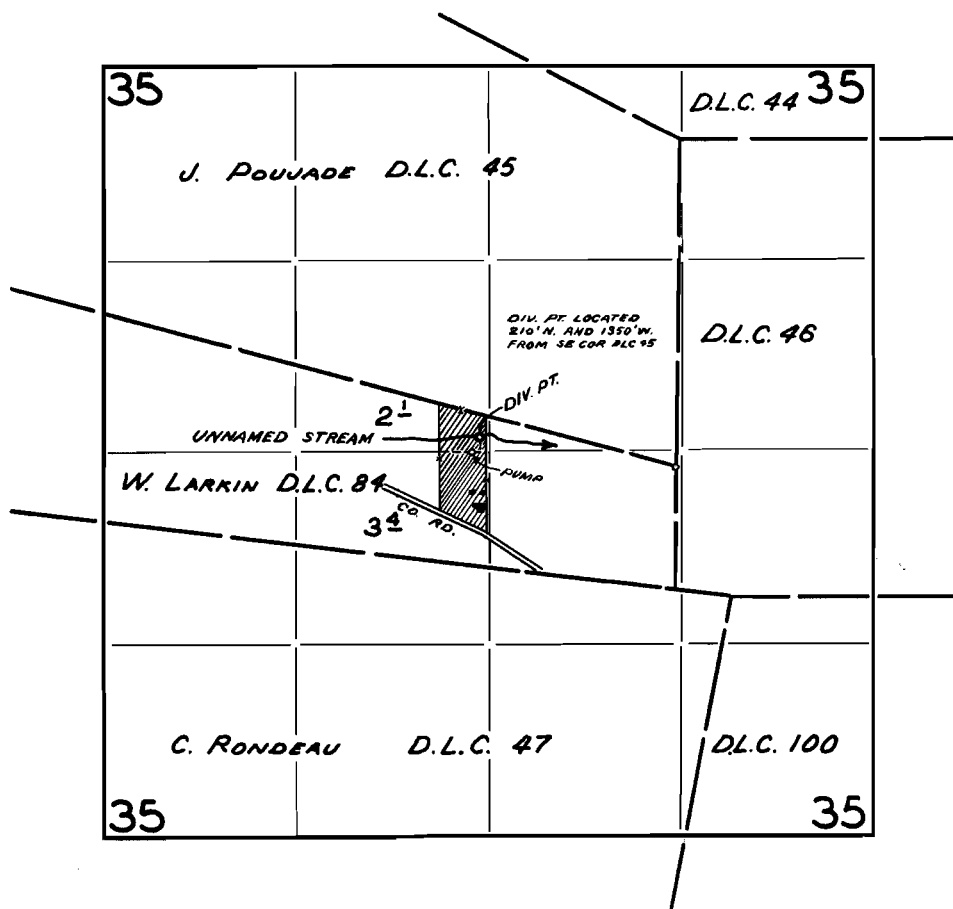

FINAL PROOF SURVEY
UNDER

Application No. 40211 Permit No. 29992

IN NAME OF

HAROLD L. MARTIN

Surveyed MAY 14 1965, by C. GARDNER