


T.9S.R.2W.W.M.

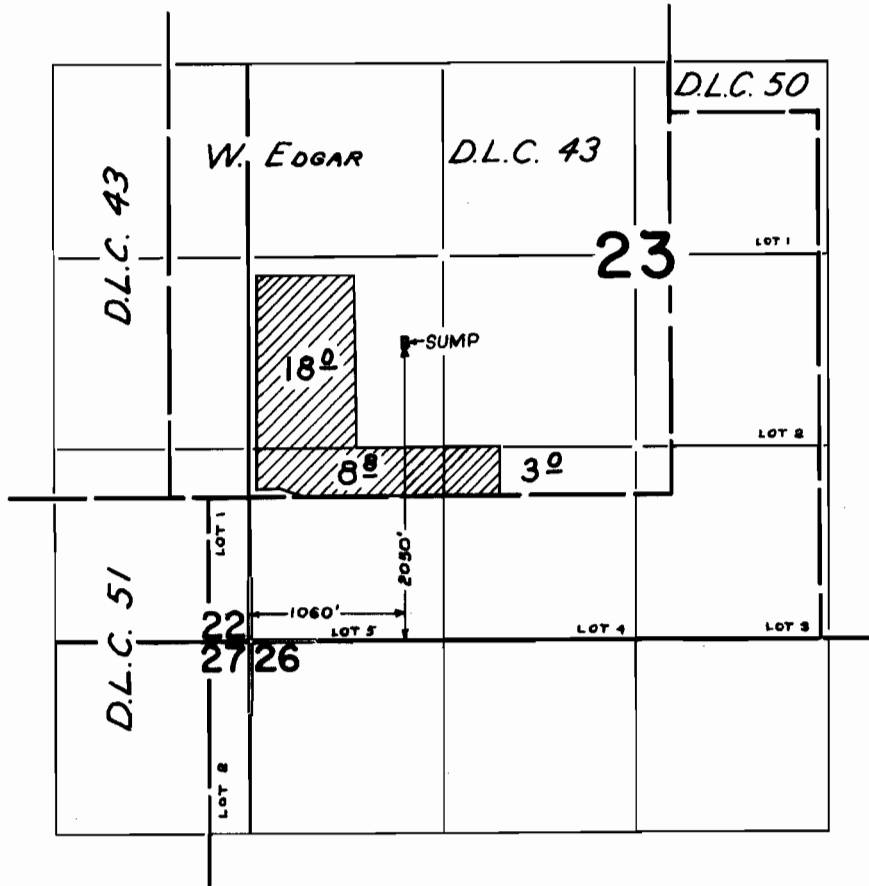

FINAL PROOF SURVEY UNDER

Application No. G-2173 Permit No. G-2004
IN NAME OF

Honoras H. Ralphs

Surveyed JUN 15 1965, by C. GARDNER