


T. 9S. R. 2W. W.M.

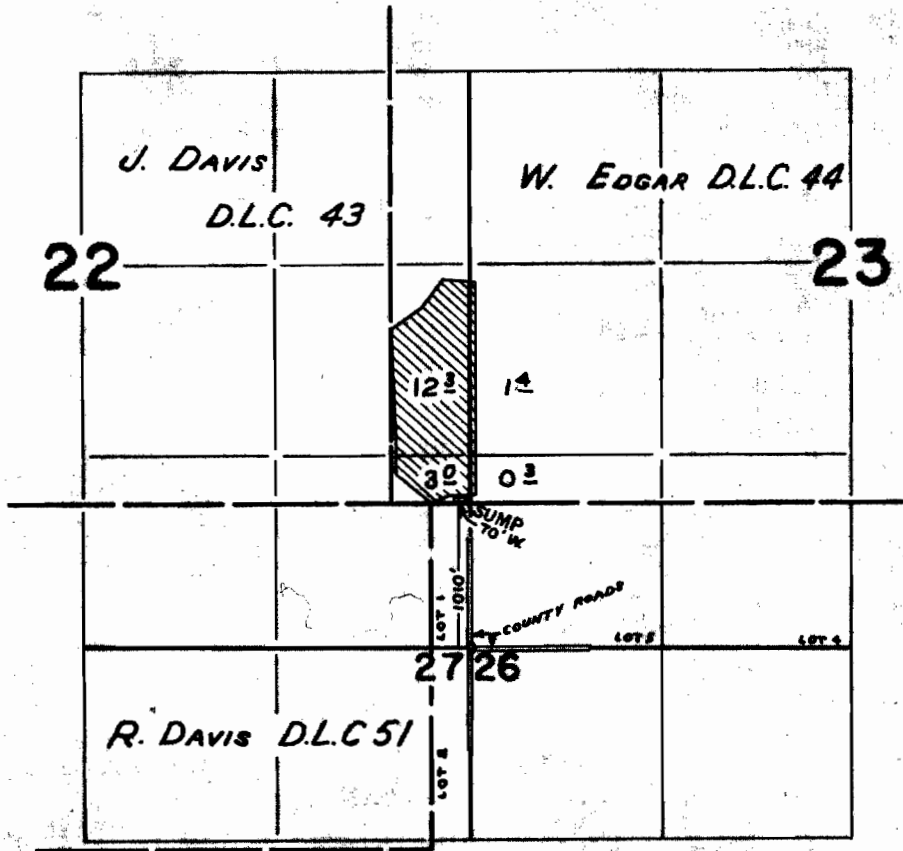

**FINAL PROOF SURVEY**  
UNDER

Application No. G-2735 Permit No. G-2535  
IN NAME OF

Honoras H. Ralphs

Surveyed JUN. 15 1965, by C. GARDNER