


T.6S.R.2W.W.M.

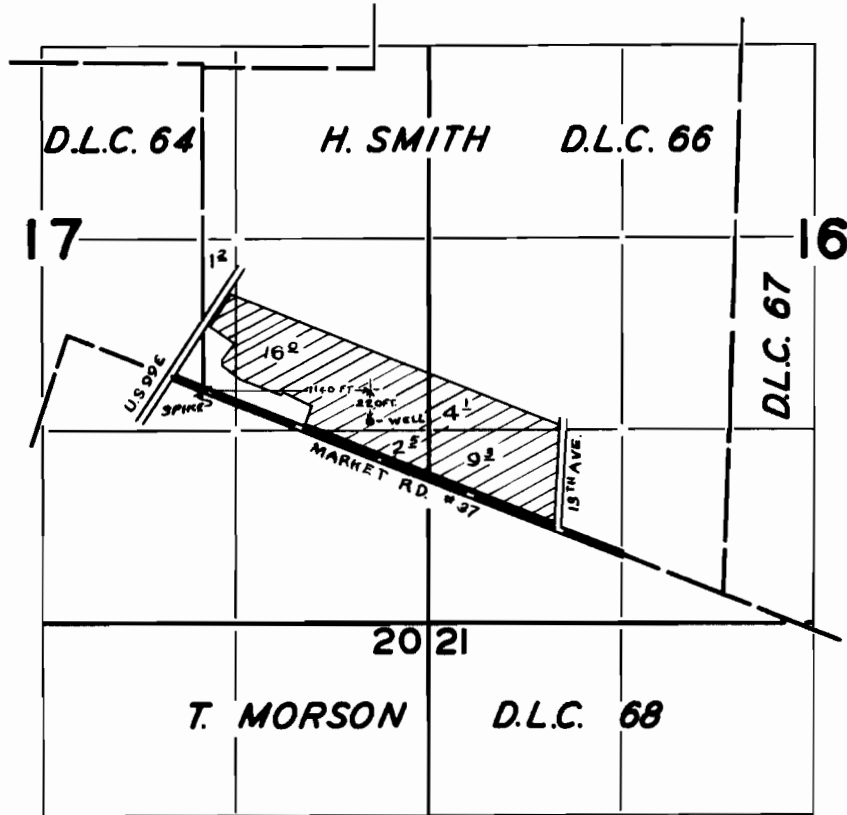

**FINAL PROOF SURVEY**  
UNDER

Application No. G-2212 Permit No. G-2037  
IN NAME OF

**SAM RAMP**

Surveyed JUL 8 1965, by L. COLEBANK