
## T. 9S.R.IW. W.M.

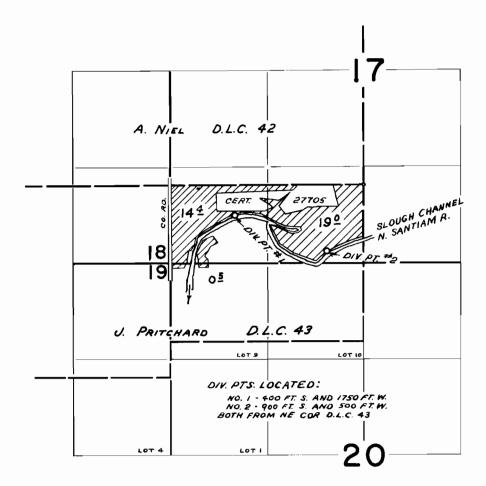

## FINAL PROOF SURVEY

Application No. 34350 Permit No. 27009 IN NAME OF			
John W. Roop			
Surveyed Jul 9	1965	hv	C. GARDNER