


T. 3 & 4 S. R. 2 W. W. M.

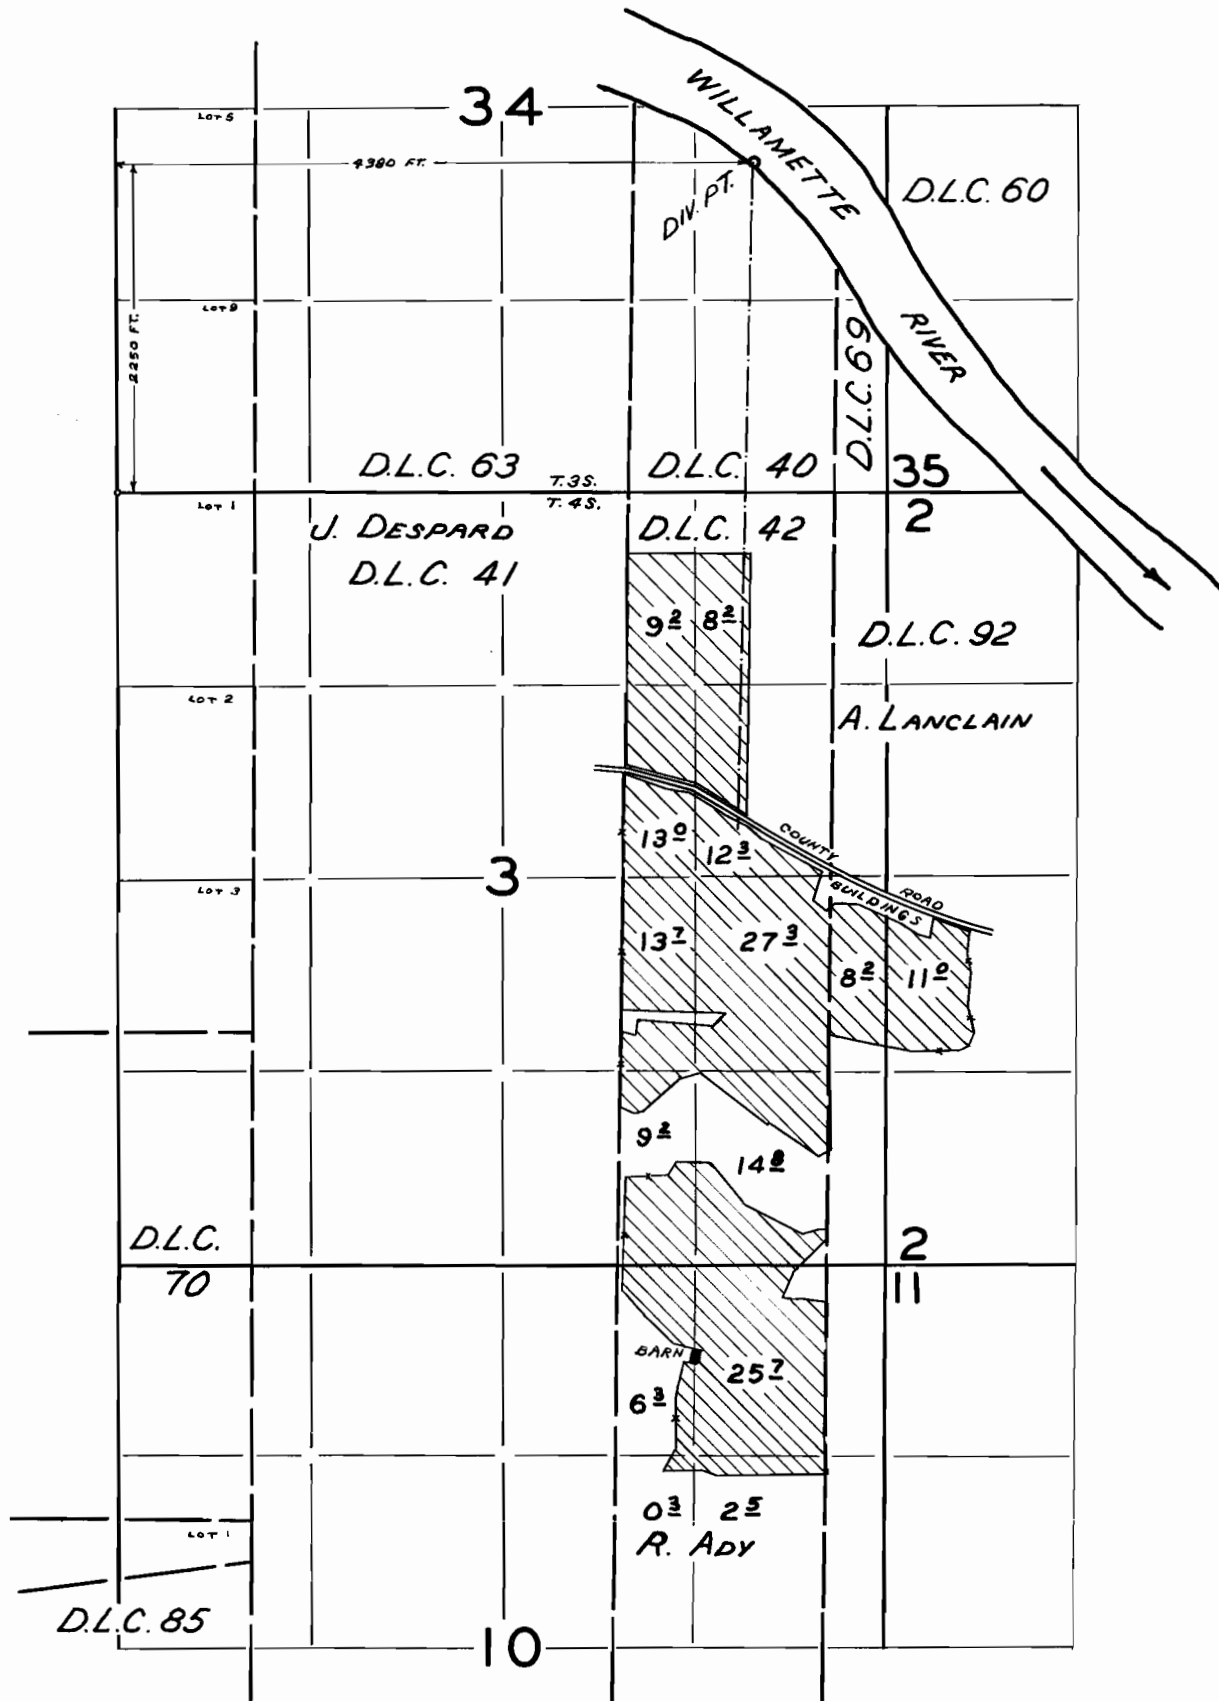

FINAL PROOF SURVEY  
UNDER

APPLICATION NO. 34860, PERMIT NO. 27361

IN NAME OF

TAROLTA P. SMITH

SURVEYED APR. 20-22, 1965 by C. GARDNER