


T.6S.R.1W.W.M.

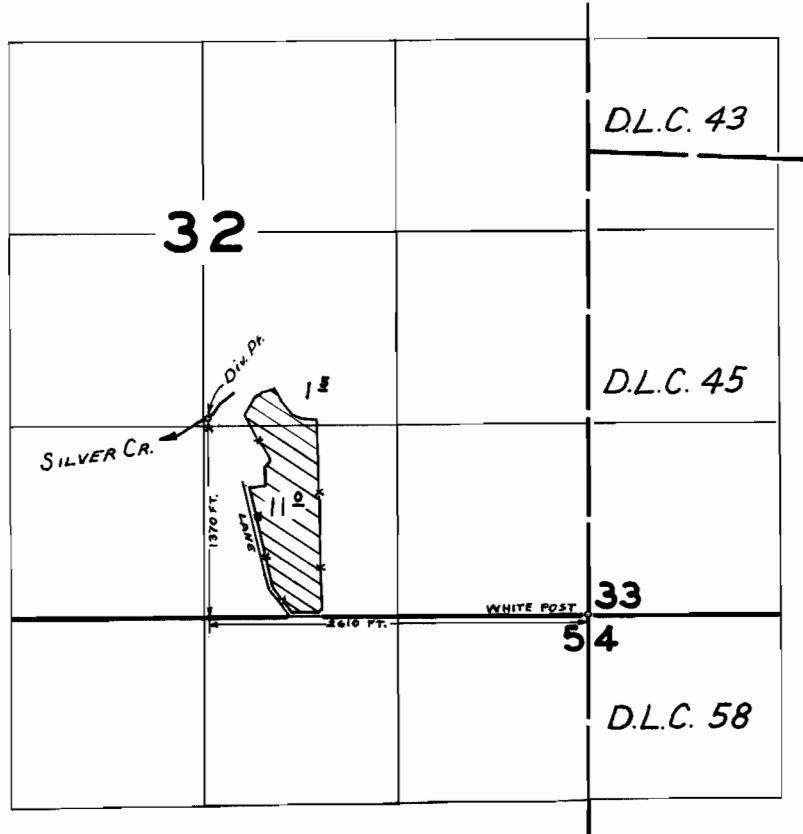

FINAL PROOF SURVEY UNDER

Application No. 33954 Permit No. 26767
IN NAME OF

OSCAR STRAND

Surveyed JUN. 2 1965, by L. COLEBANK