


T.9S.R.2W.W.M.

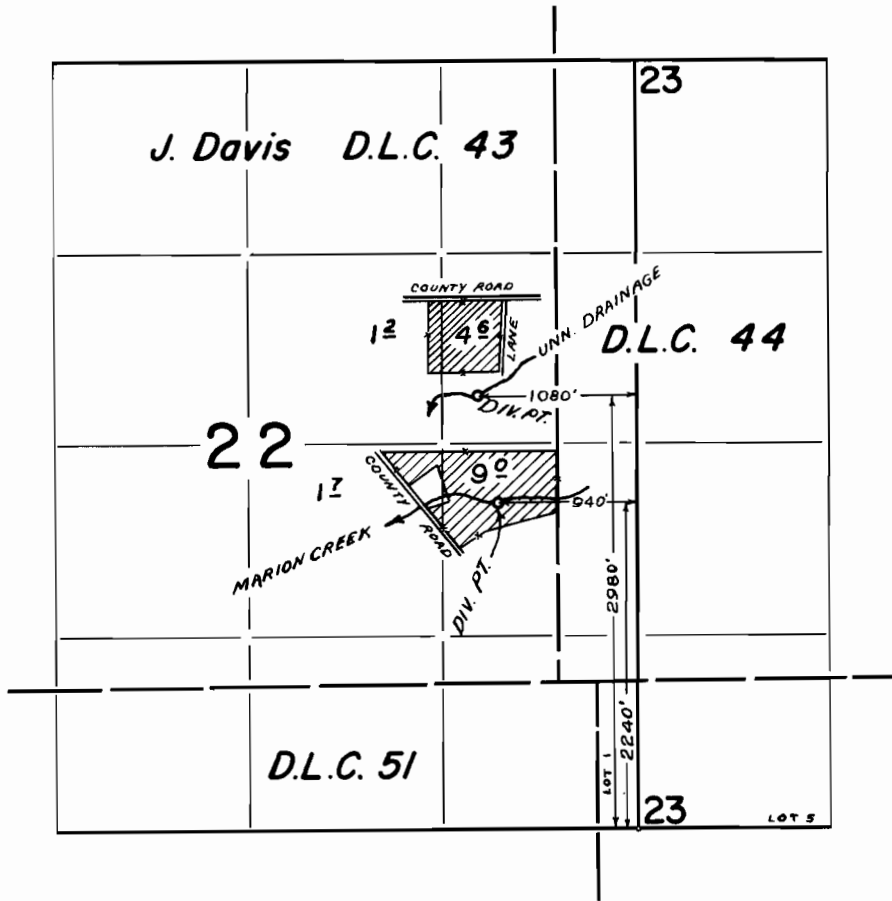

FINAL PROOF SURVEY UNDER

Application No. 37945 Permit No. 28301
IN NAME OF

Peter J. and Patricia R. Tolmasoff

Surveyed JUN. 15 1965, by C. GARDNER