


T. 4 S. R. 2 W. W.M.

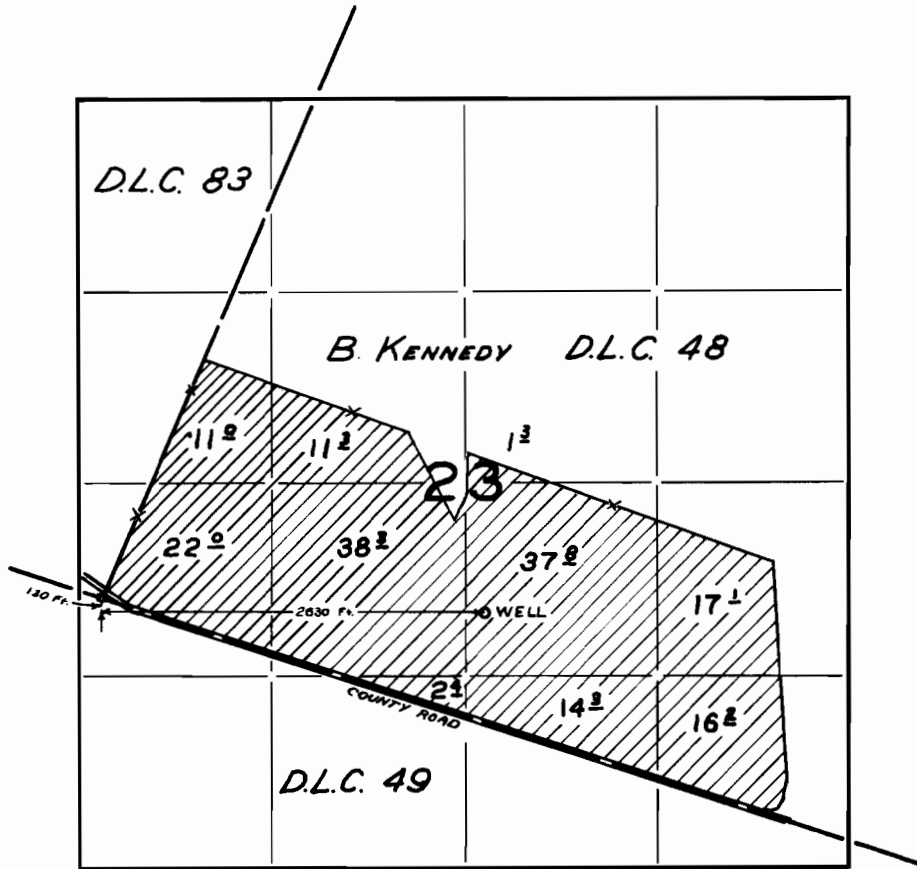

FINAL PROOF SURVEY
UNDER

Application No. G-2359 Permit No. G-2177

IN NAME OF

JOSEPH WILMES

Surveyed APR. 15, 1965, by C. GARDNER