


T. I. S. R. I. E. W. M.

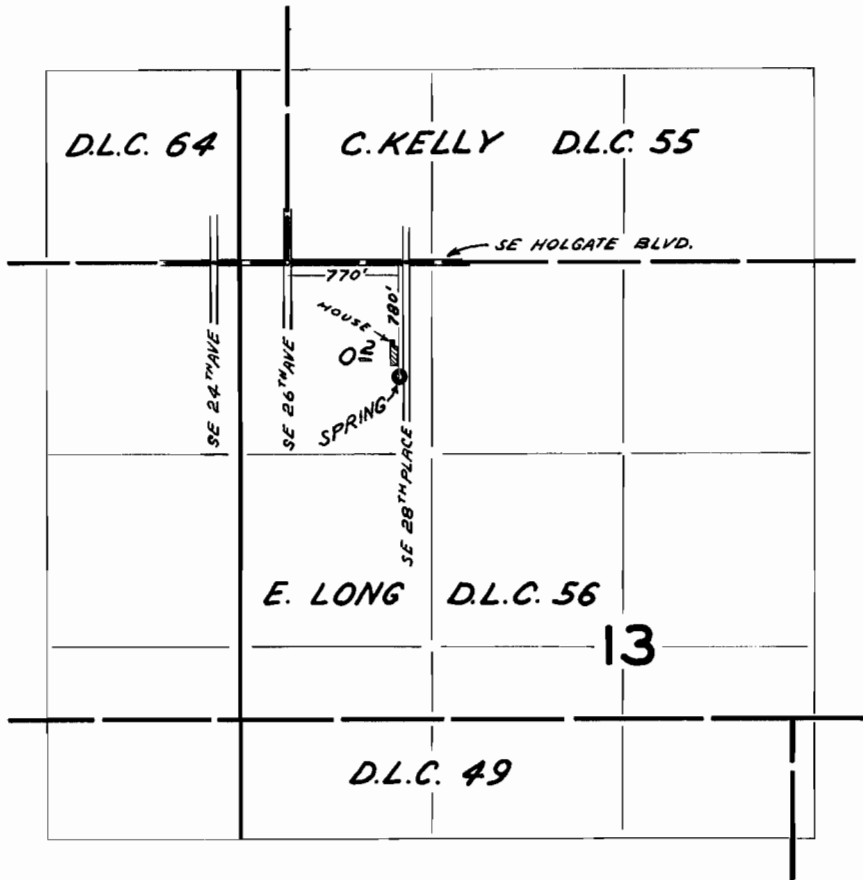

FINAL PROOF SURVEY UNDER

Application No. 33612 Permit No. 26577
34502 27144

IN NAME OF

WALTER J. RATH

Surveyed SEP. 9 1965, by C. GARDNER