


T. 8 S. R. 6 W. W. M.

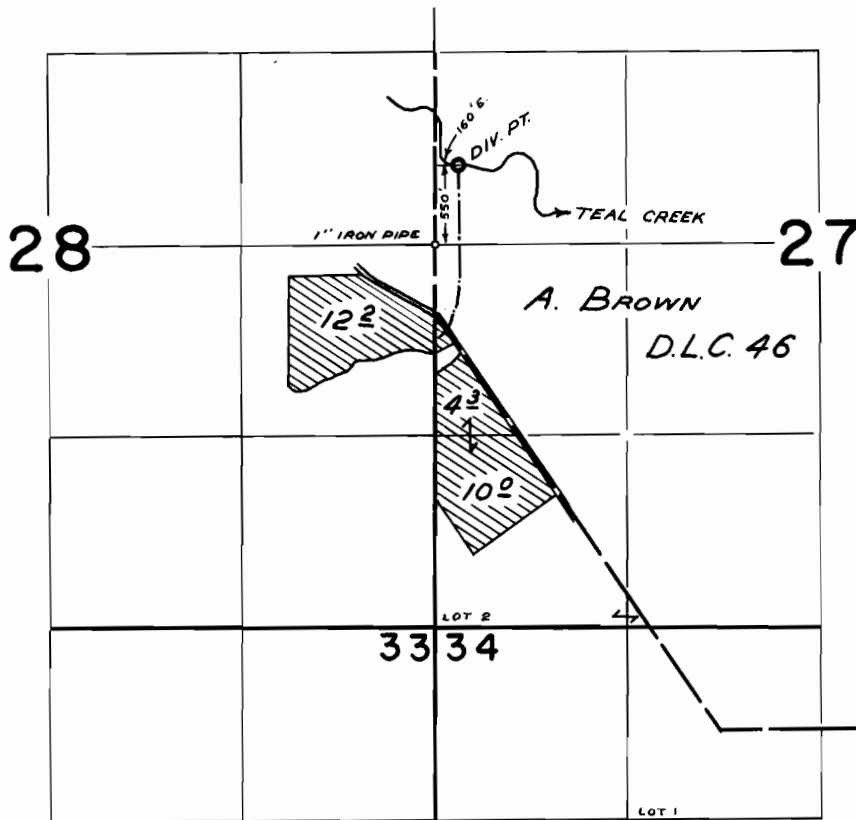

FINAL PROOF SURVEY
UNDER

Application No. 32288 Permit No. 25524

IN NAME OF

John Qualey

Surveyed Aug. 3 1965, by C. GARDNER