


T. 4 S. R. 35 E. W. M.

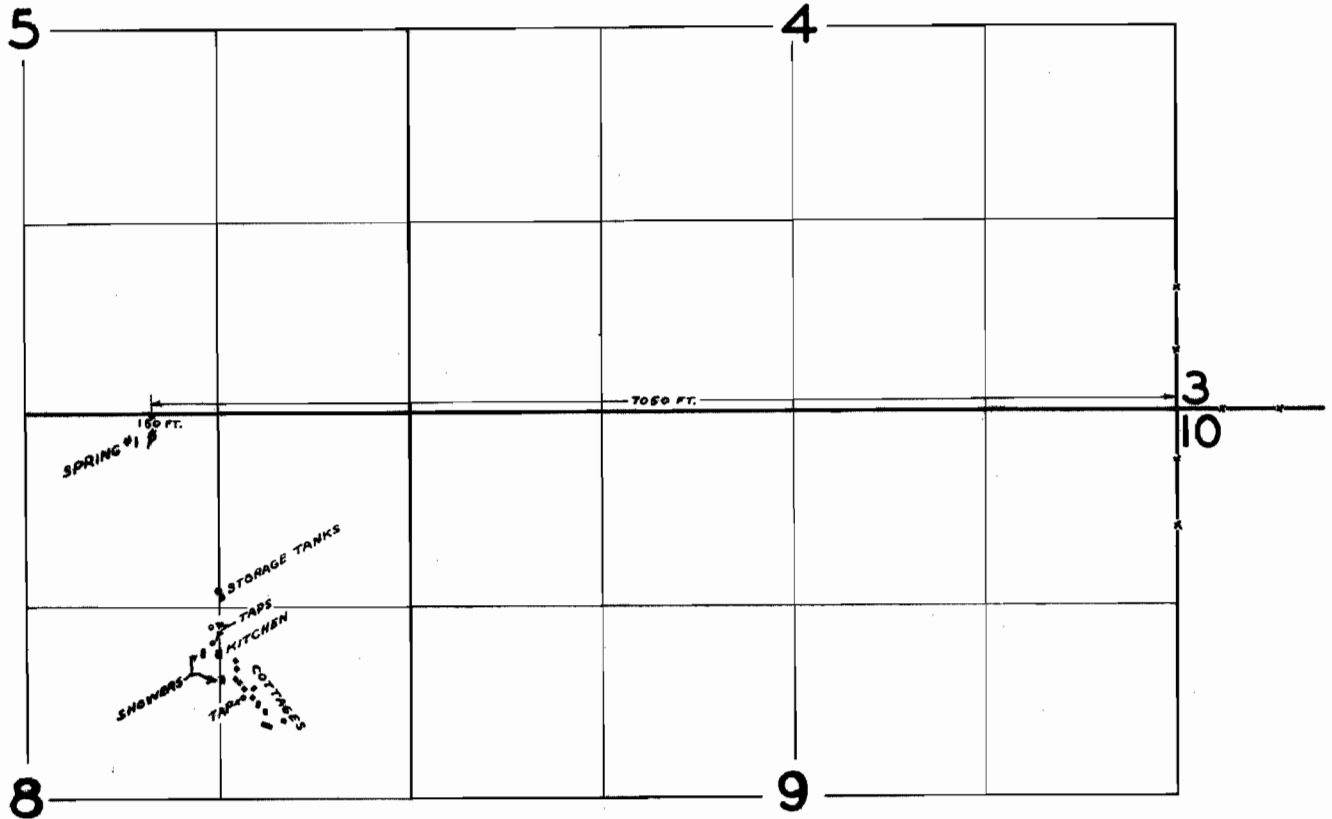

**FINAL PROOF SURVEY**  
UNDER

Application No. 35032 Permit No. 27475  
IN NAME OF  
**BLUE MOUNTAIN**  
**CONSERVATIVE BAPTIST ASSN.**

Surveyed Nov. 3 1965, by C. GARDNER