


T.2S.R.38E.W.M.

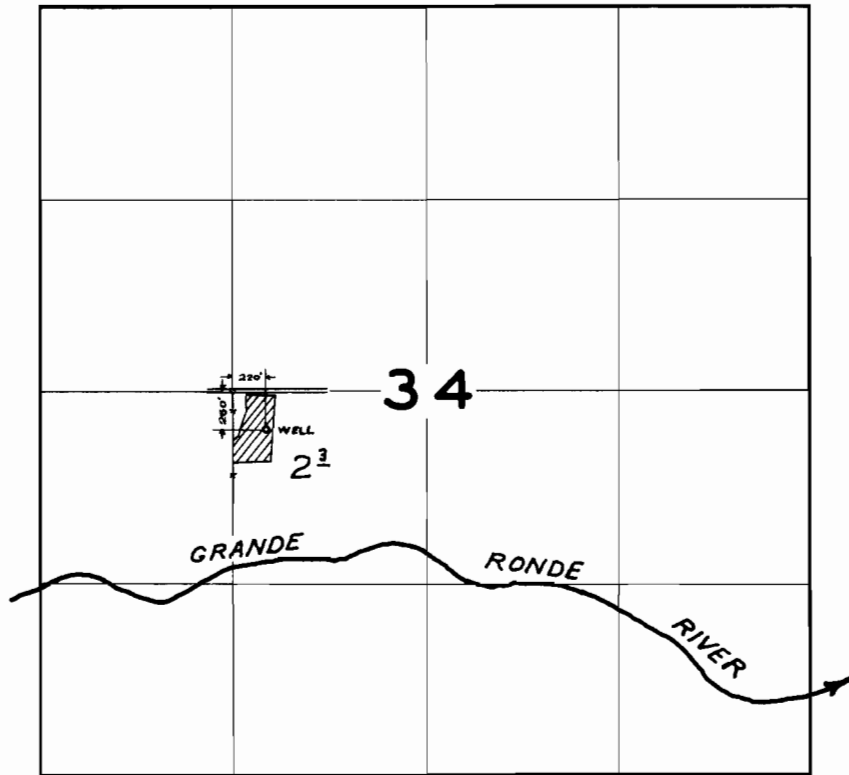

FINAL PROOF SURVEY
UNDER

Application No. G-2482 Permit No. G-2292
IN NAME OF

NORVAL G. OLSON

Surveyed Oct. 30, 1965, by C. GARDNER