


T.3N.R.40E.W.M.

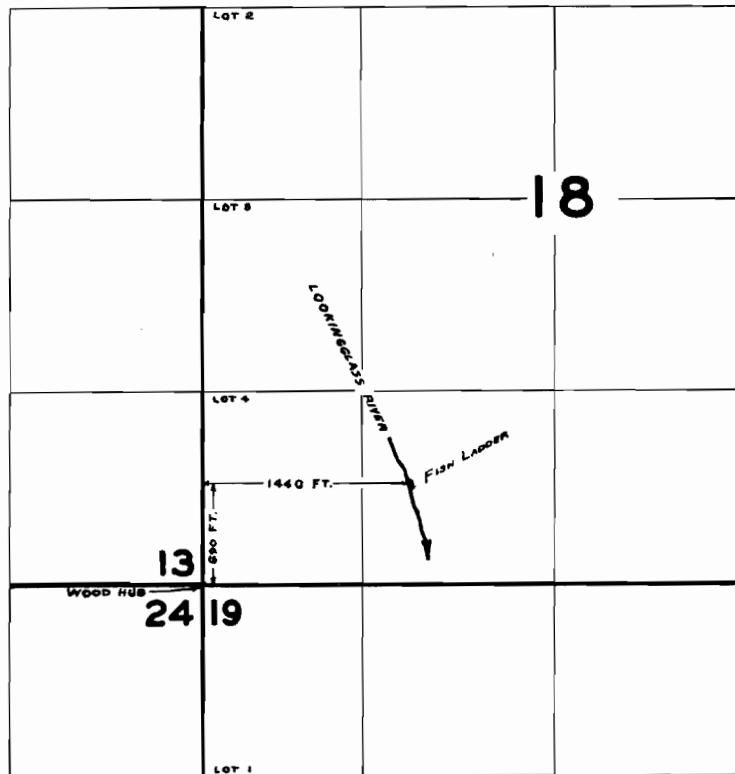

**FINAL PROOF SURVEY**  
UNDER

Application No. 34561 Permit No. 27091  
IN NAME OF

**OREGON STATE FISH COMMISSION**

Surveyed Oct. 29, 1965, by C. GARDNER