


T.1N.&1S.R.38E.W.M.

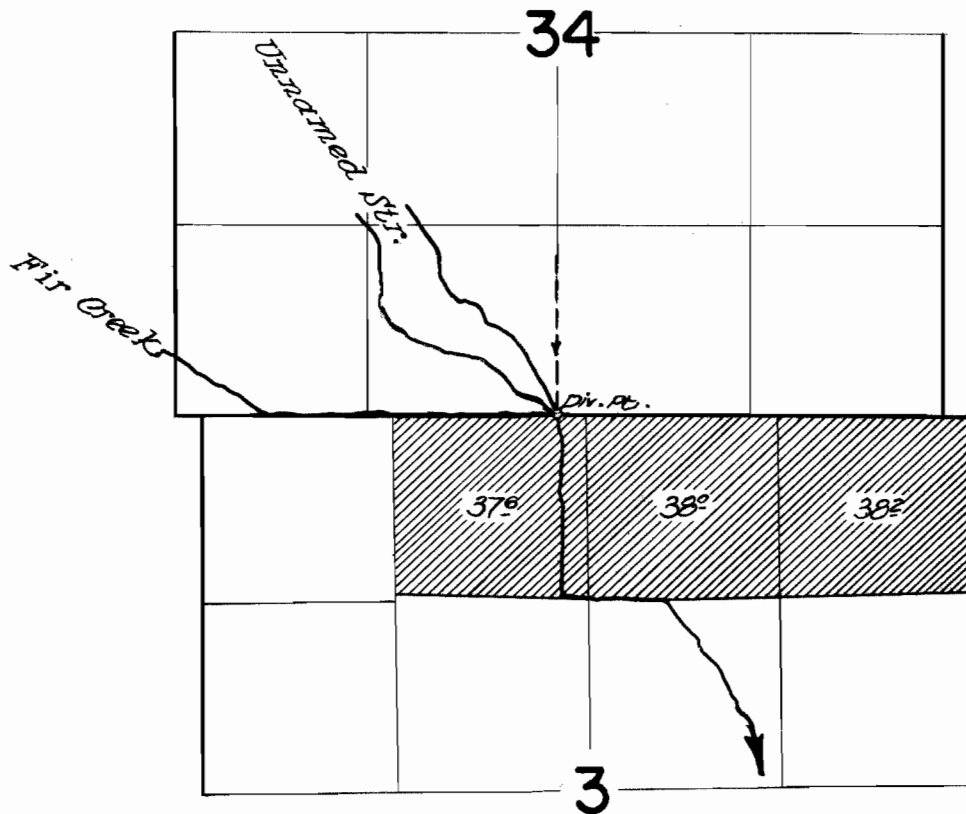

FINAL PROOF SURVEY
UNDER

Application No. 38086 Permit No. 28394
IN NAME OF

GEORGE ROYES

Surveyed Sept. 30 1963, by T. Lauer