


T.4S. R.3W. W.M.

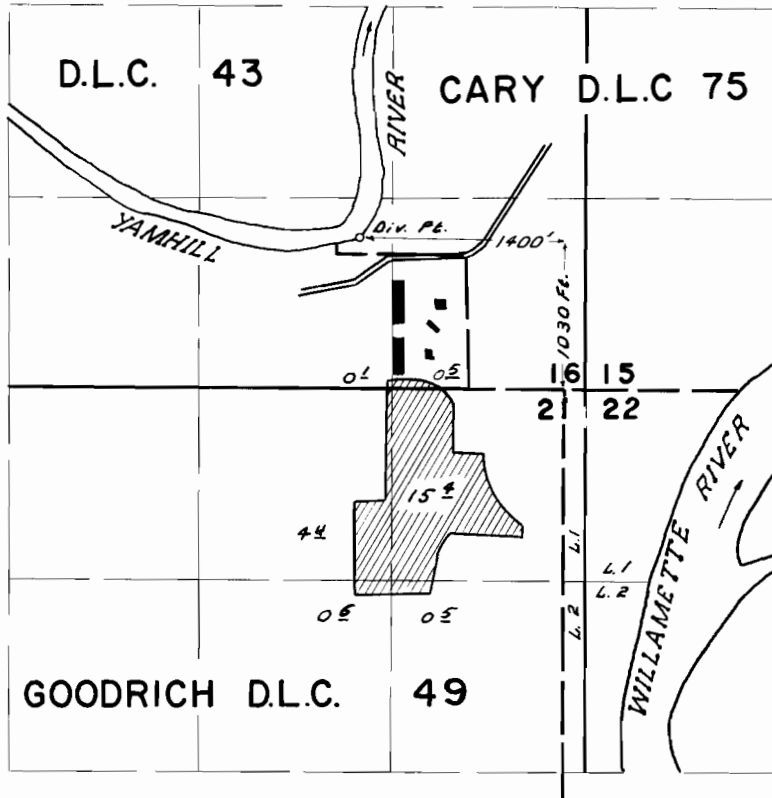

FINAL PROOF SURVEY
UNDER

Application No. 37310 Permit No. 27795
IN NAME OF

ROGER DUMDI

Surveyed AUG 20 1965, by L. COLEBANK