


T.2S. R.2W. W.M.

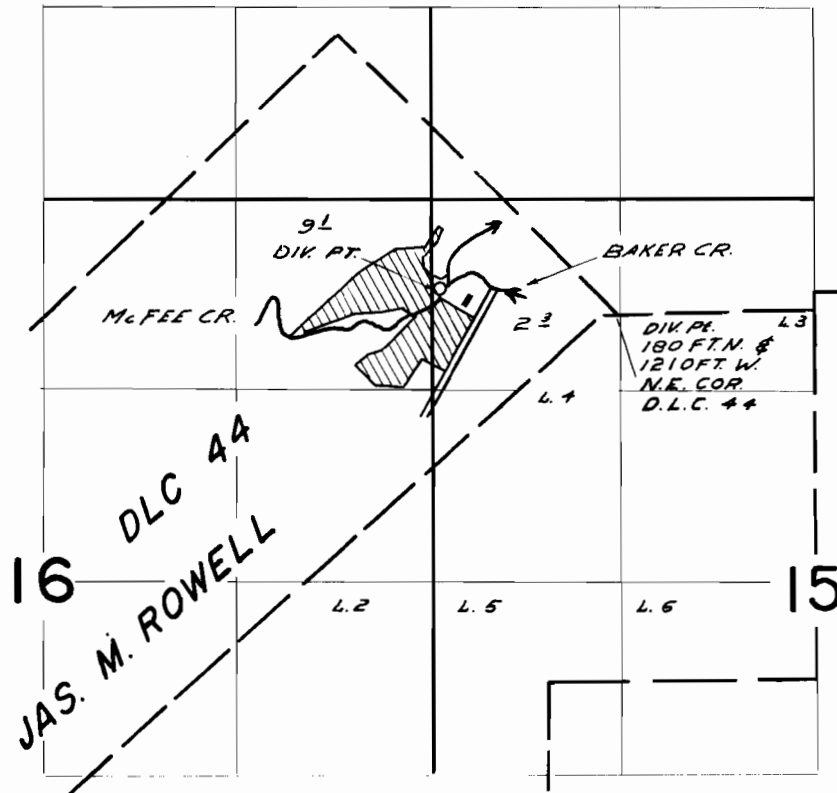


FINAL PROOF SURVEY
UNDER

Application No. **19635** Permit No. **15227**
IN NAME OF

STANFORD A. GOTTER

Surveyed **MAY 28 1951**, by **H. L. COFFMAN**

T.2S. R.2W.W.M.

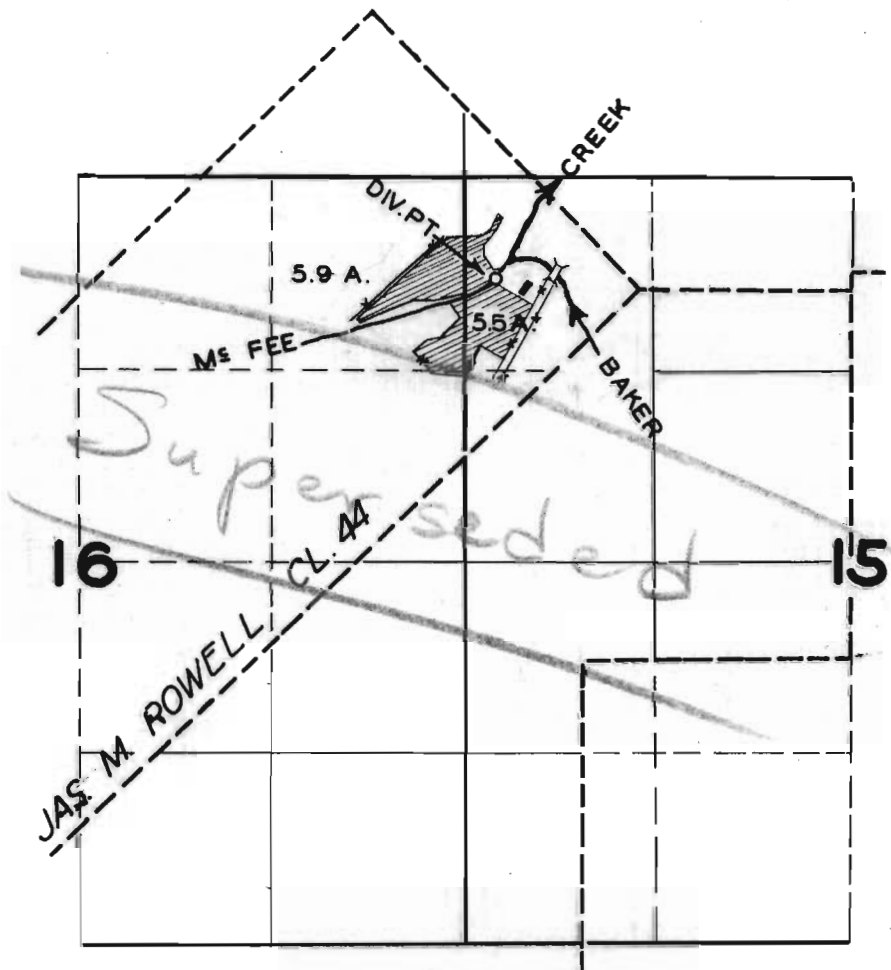

FINAL PROOF SURVEY
UNDER

Application No. 196.35 Permit No. 152.27
IN NAME OF

STANFORD A. GOTTER

Surveyed MAY 28 1951, by H.L. COFFMAN