


# T.5S.R.3W. W.M.

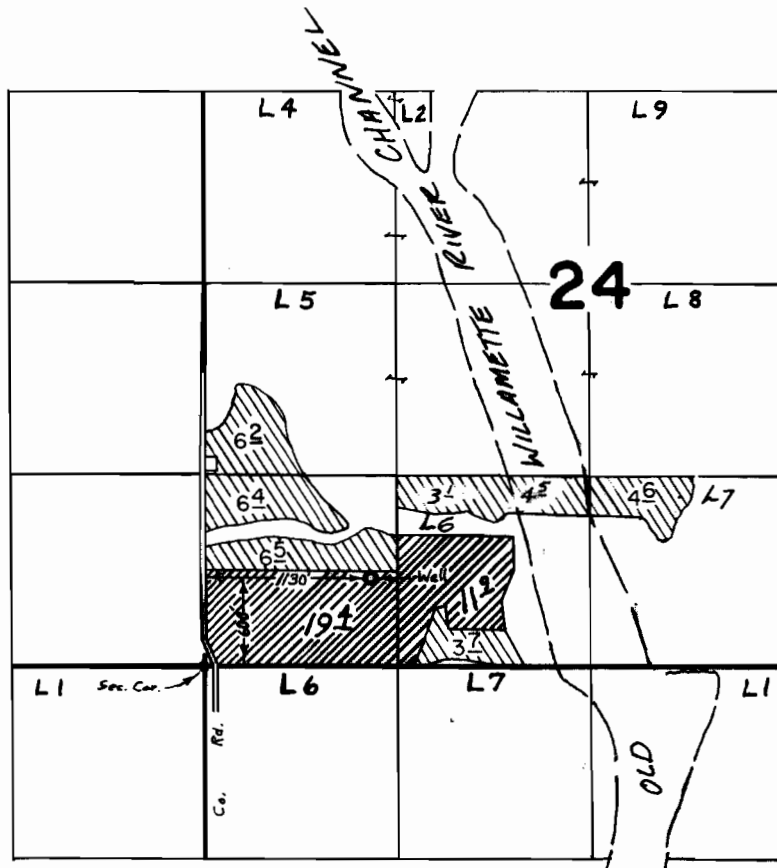

## FINAL PROOF SURVEY UNDER

G-7748                      G-7177  
Application No. *G-3120* Permit No. *G-2927*  
IN NAME OF

**ARNOLD E. HILDEBRANDT**

Surveyed *April 7, 1967*, by *L.E. Gould*.....  
MAY 28, 1980, *[Signature]*

