


T.10S. R.7 W.W.M.

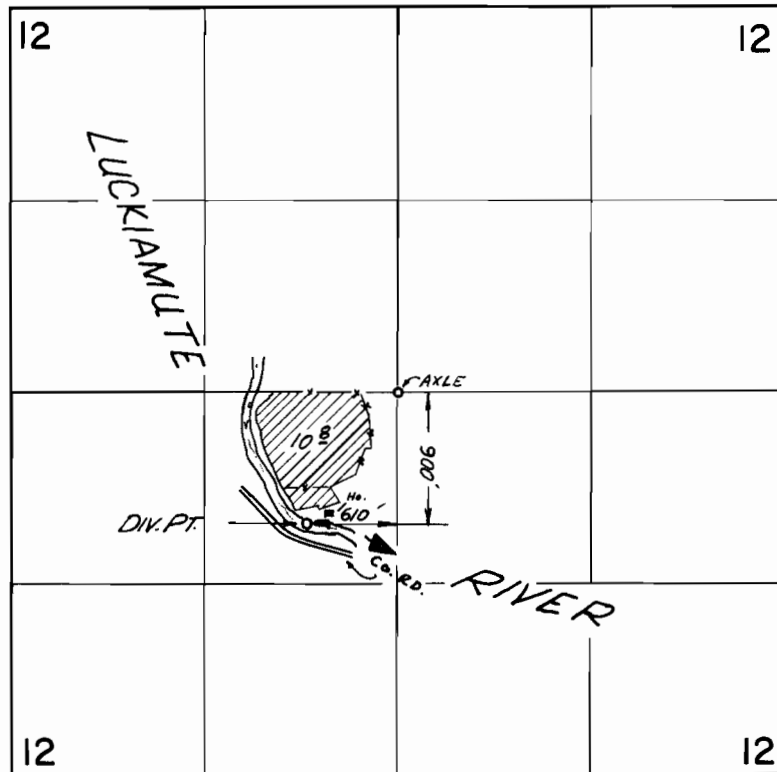

FINAL PROOF SURVEY UNDER

Application No. 39001 ... Permit No. 29054
IN NAME OF

FRED M. JONES

Surveyed *April 8*, 1966, by *V. GARNER*.....