


T. 11 S. R. 5 W. W.M.

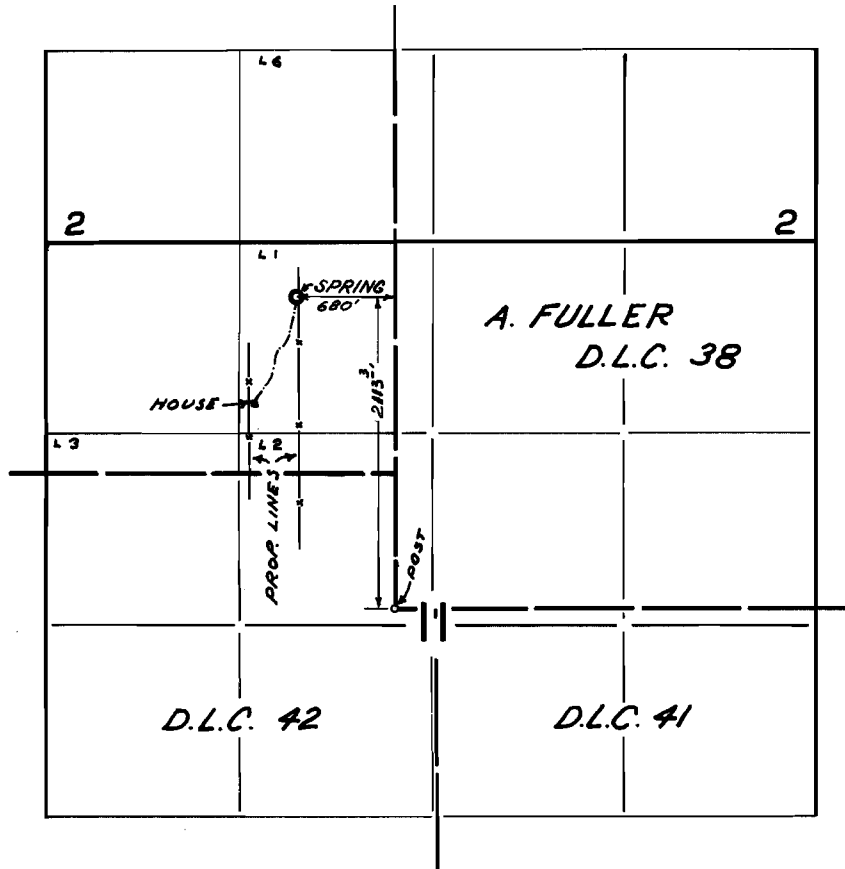

FINAL PROOF SURVEY UNDER

Application No. 40761 Permit No. 30354
IN NAME OF

NORA I. MILLER

Surveyed SEP 2 1965, by R. JACKSON