


T. IS. R. 4 E. W. M.

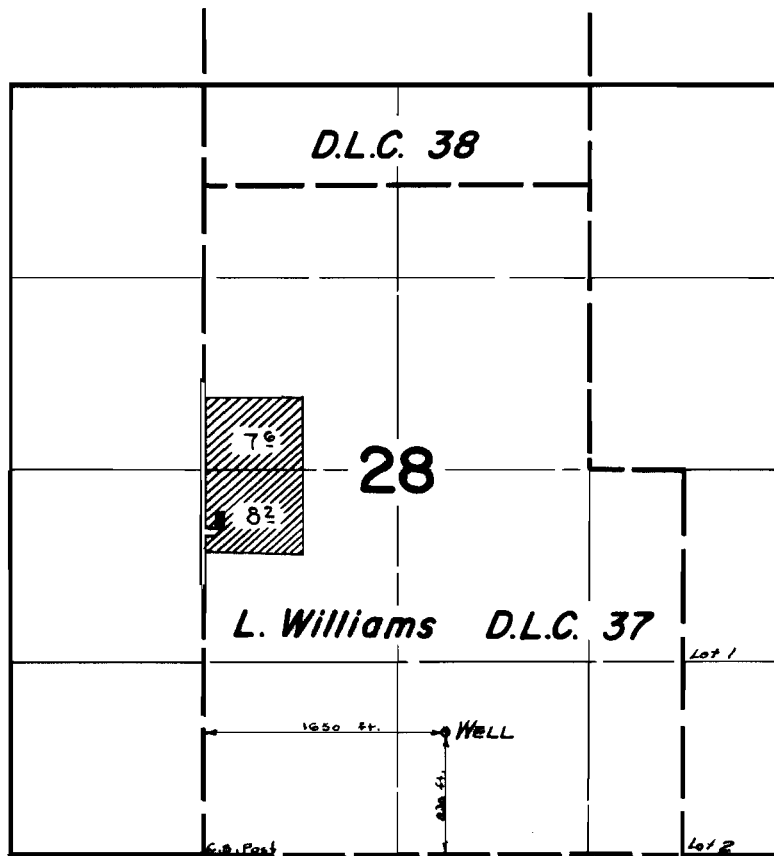

FINAL PROOF SURVEY UNDER

Application No. **G-2258** Permit No. **G-2100**
IN NAME OF

HOOD ACRES CORPORATION

Surveyed *August 18* 1965, by *Alpherson*