


T.3S.R.4E.W.M.

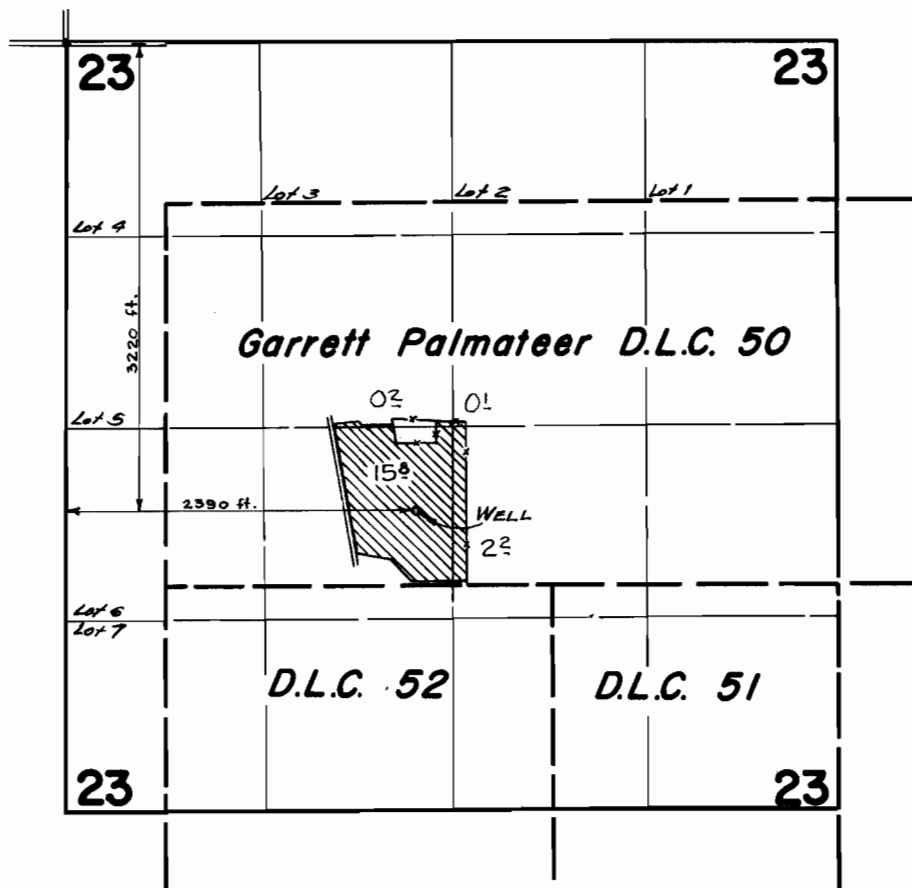

FINAL PROOF SURVEY
UNDER

Application No. G-1283 Permit No. G-1163
IN NAME OF

GEORGE D. RANDALL

Surveyed April 22 1965 by

[Signature]