


T.3S.R.1W.W.M.

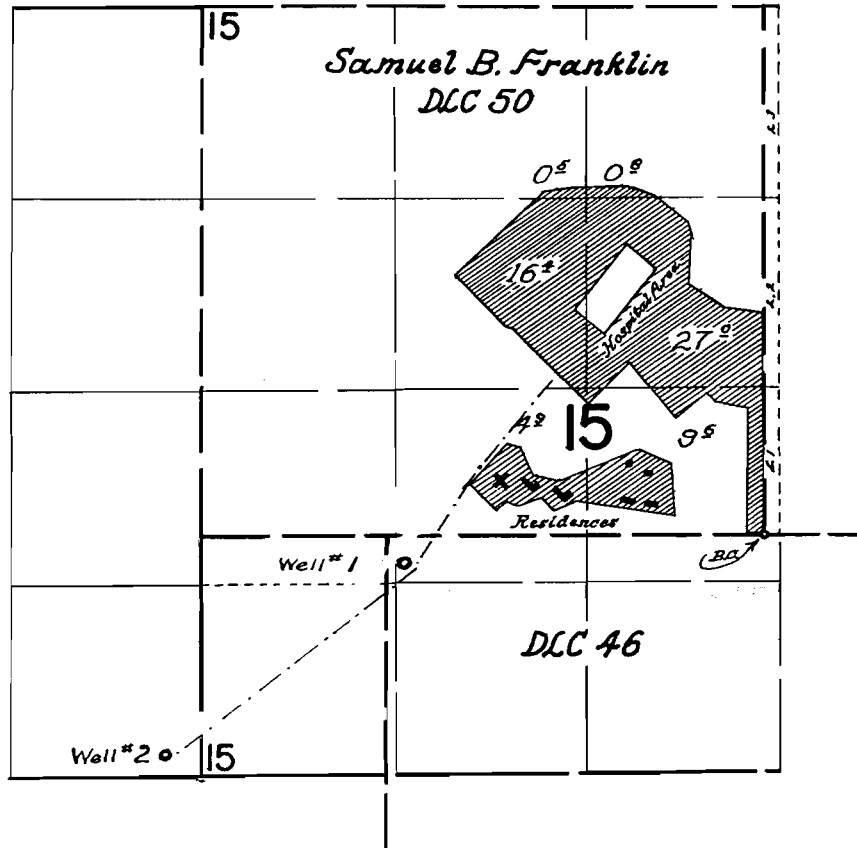

*Note: Location of Well #1 taken from
Application Map*

FINAL PROOF SURVEY UNDER

G-802 G-691
Application No. *G-1517* Permit No. *G-1384*
IN NAME OF

State of Oregon, Oregon State Board of Control

Surveyed May 15, 1962, by Thomas R. Lauer
Inspected May 13, 1965 by R. JACKSON