


T.4S.R.2E.W.M.

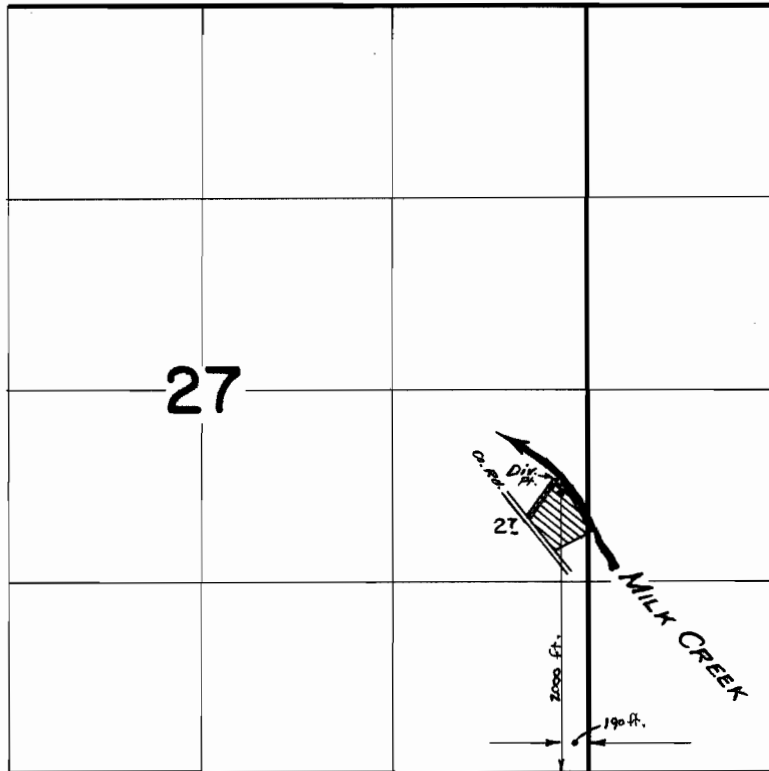

FINAL PROOF SURVEY
UNDER

Application No. **38624** Permit No. **28753**
IN NAME OF

WILLIAM A. STROBEL

Surveyed *April 13* 1965, by *A. Jackson*