


T.5S.R.1E.W.M.

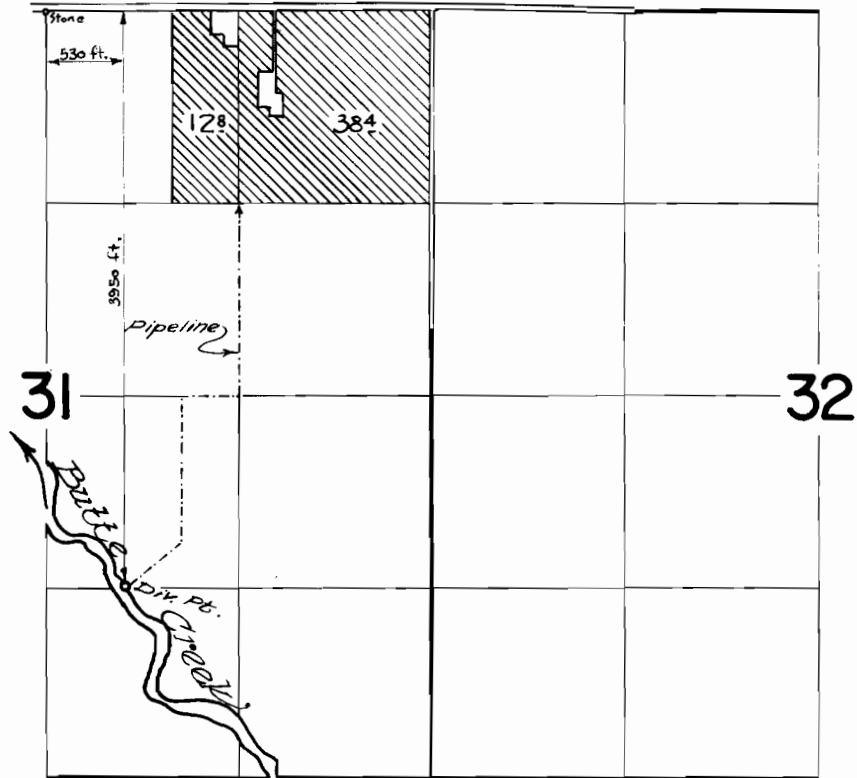

FINAL PROOF SURVEY UNDER

Application No. **37253** Permit No. **27755** ...
IN NAME OF

C. J. VANDECOEVERING

Surveyed *April 16 1965*, by *R. J. Peck*