


T.27S.R.13W.W.M.

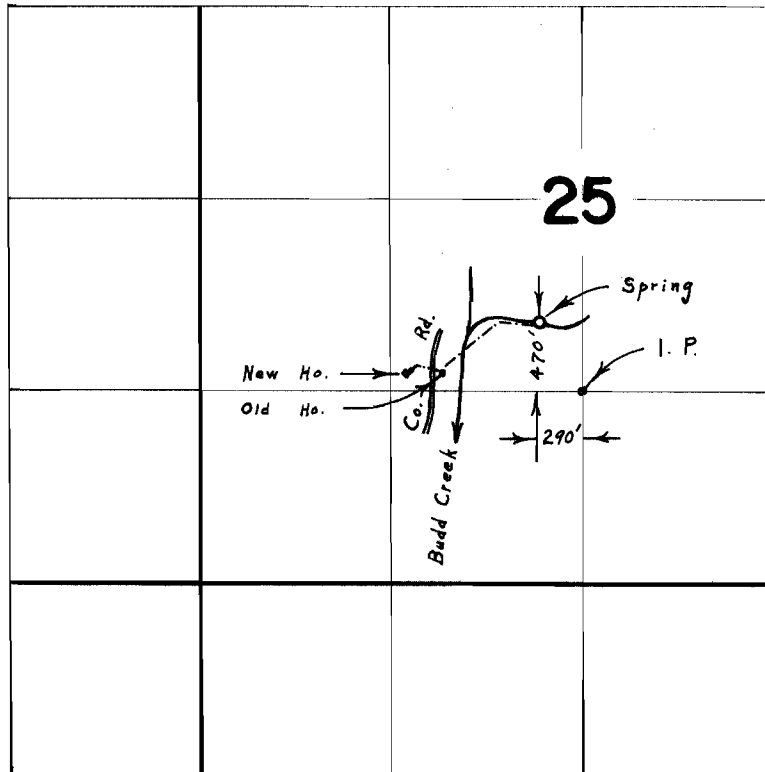

FINAL PROOF SURVEY
UNDER

Application No. 38866 Permit No. 28947
IN NAME OF

LILA J. SPALDING

Surveyed Oct. 11 1966, by L. E. Gould