


T.22 S.R.8 W.W.M.

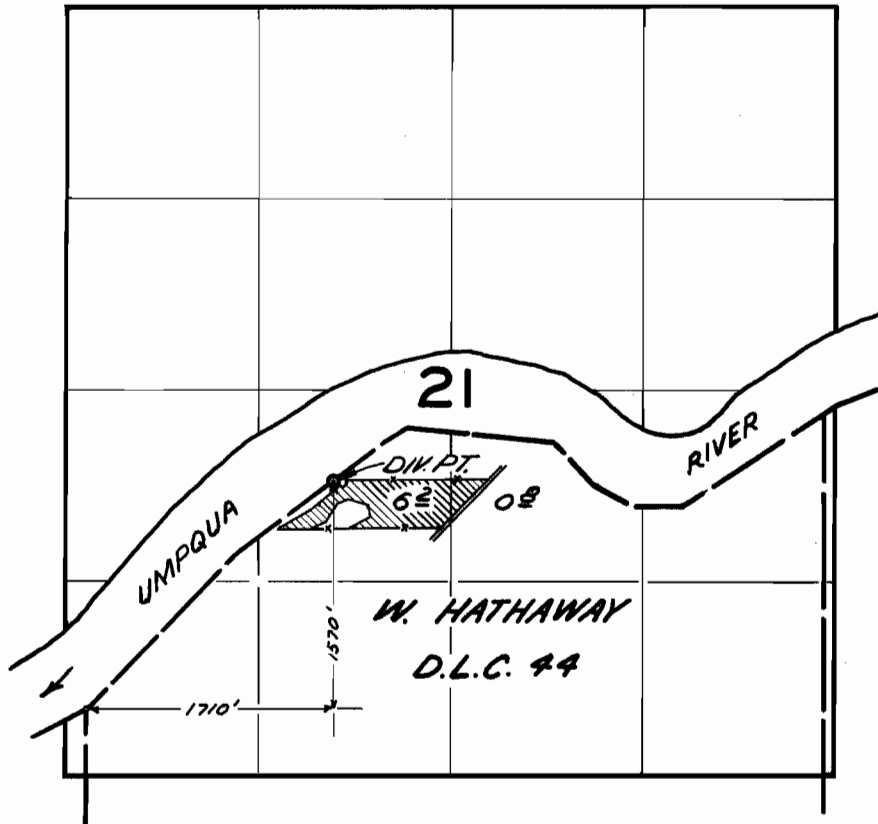

FINAL PROOF SURVEY
UNDER

Application No. 39145 Permit No. 29129
IN NAME OF

AULDEN AND RUTH CHEEVER

Surveyed JUN. 9, 1965, by R. JACKSON