


T. 23 S. R. 7 W. W.M.

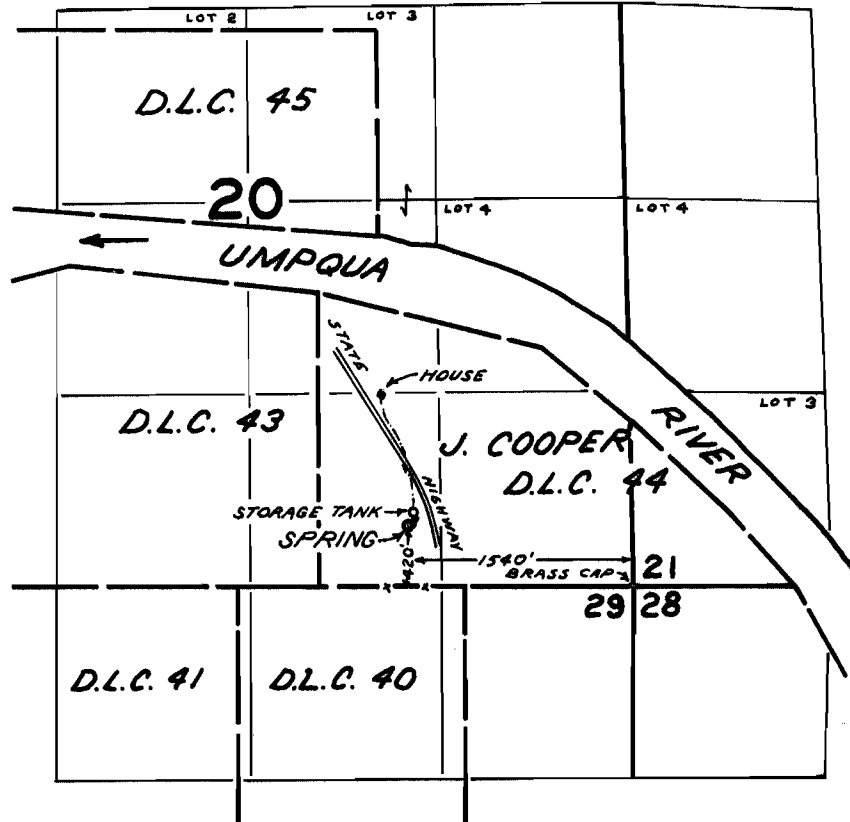

FINAL PROOF SURVEY
UNDER

Application No. 39476 Permit No. 29392
IN NAME OF

PERRY GEORGE

Surveyed JUN 12 1965, by R. JACKSON