


T. 22 S. R. 6 W. W. M.

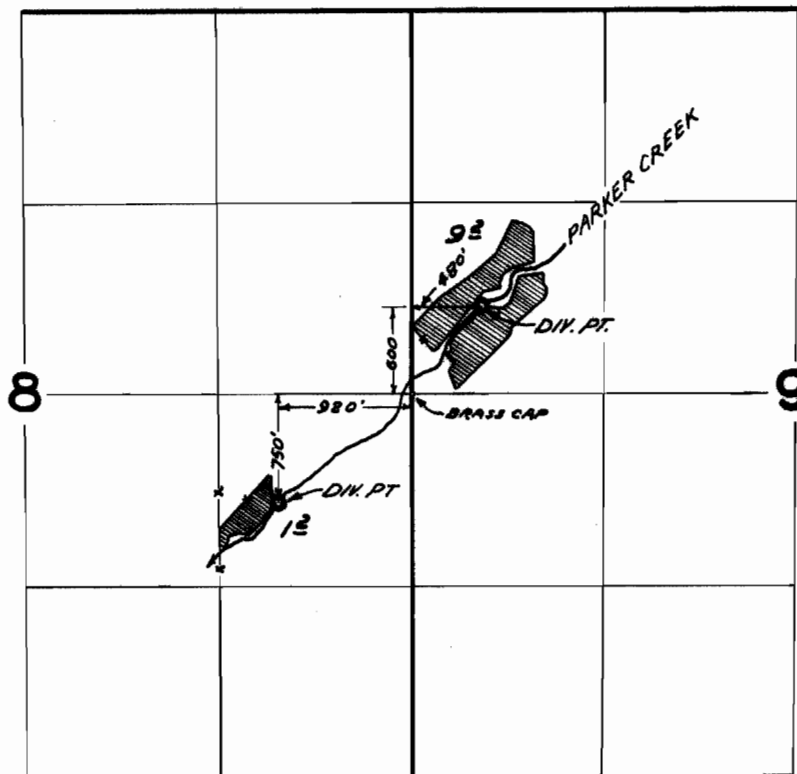

FINAL PROOF SURVEY
UNDER

Application No. 37551 Permit No. 27981
IN NAME OF

ELLIS MATHIS AND/OR MELBA MATHIS

Surveyed JUN 9, 1965, by R. JACKSON