


# T.24S.R.6W.W.M.

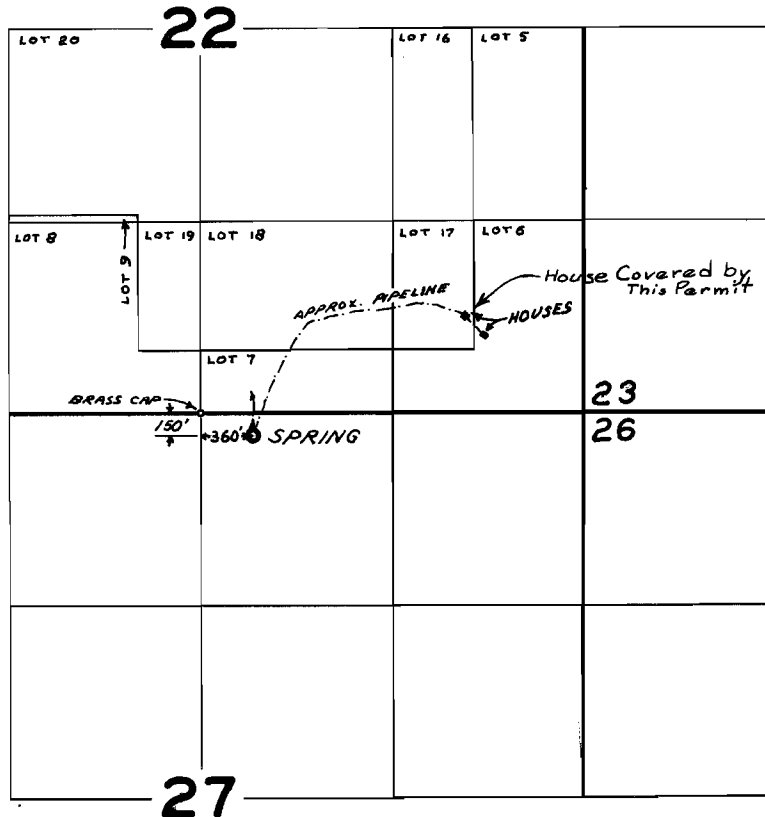

## FINAL PROOF SURVEY UNDER

Application No. 33685 Permit No. 26628  
IN NAME OF

WEST BROTHERS

Surveyed JUN. 8, 1965, by R. JACKSON