


T. 13 S. R. 31 E. W.M.

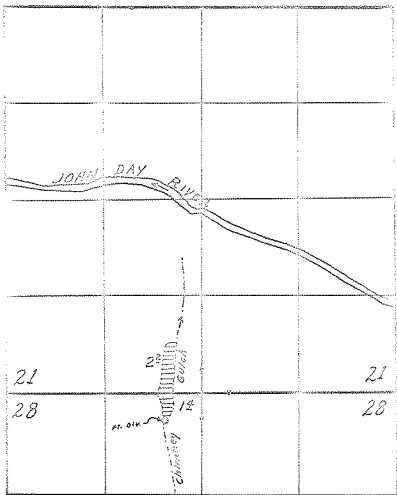

FINAL PROOF SURVEY  
UNDER

Application No. 33096... Permit No. 26165...  
IN NAME OF

DUANE L. CHEADLE

Surveyed July 7, 1964, by G. Ward

4-1964 3