


T. 39 S. R. 36 E. W.M.

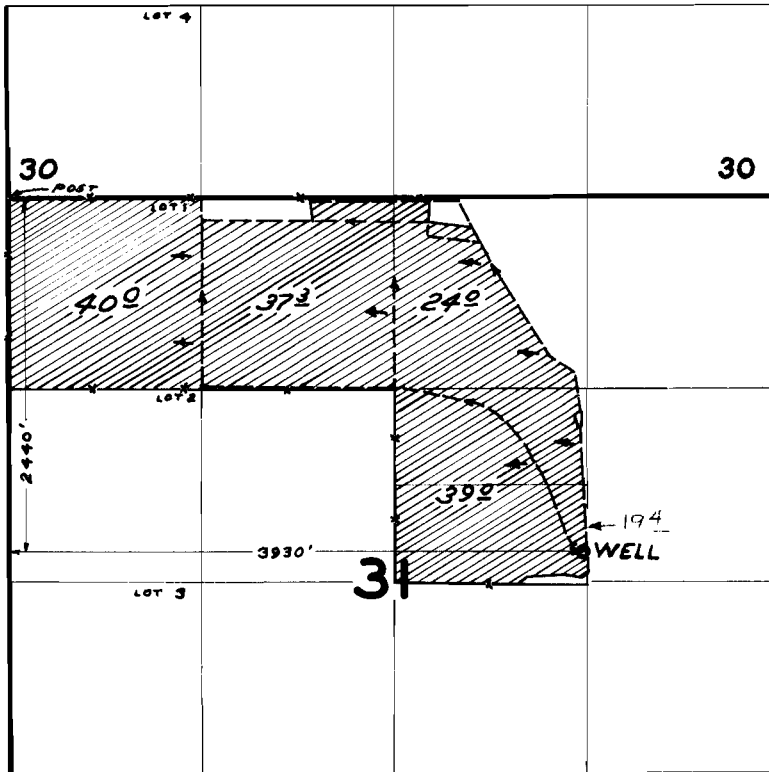

FINAL PROOF SURVEY
UNDER

Application No. G-1949 Permit No. G-1791
IN NAME OF

JAMES E. CALDERWOOD

Surveyed Oct 26 1965, by R. JACKSON