


T. 22 & 23 S. R. 31 E. W. M.

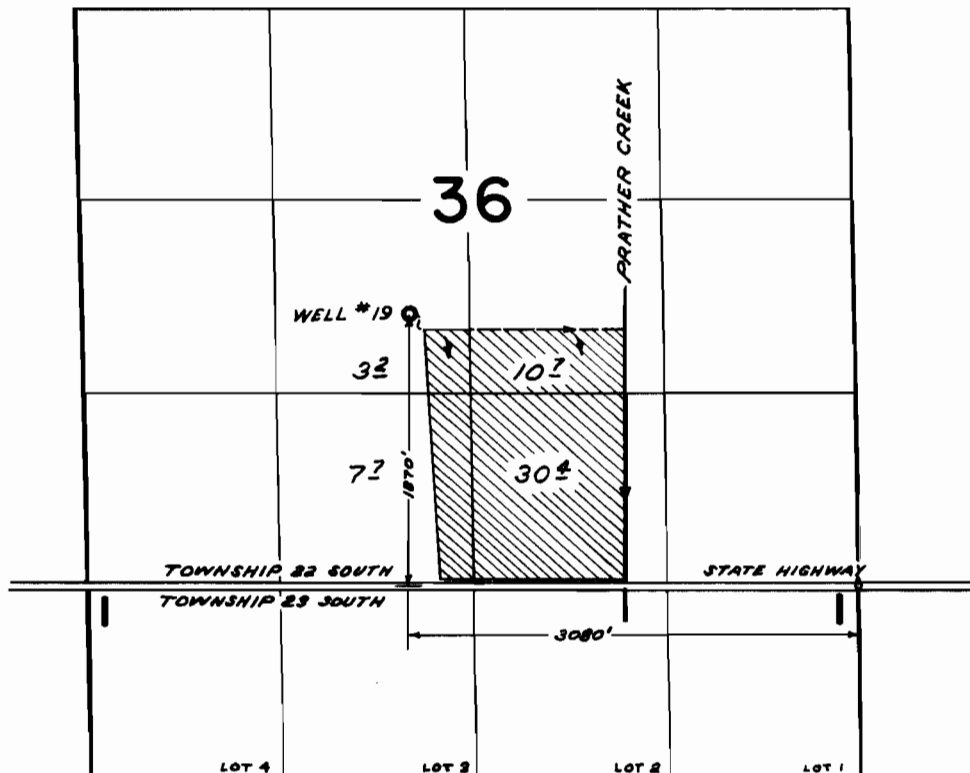

FINAL PROOF SURVEY
UNDER

Application No. G-2522 Permit No. G-2337
IN NAME OF

Harry Pon

Surveyed SEP 20 1965, by C. GARDNER