


T. 23 S. R. 32 E. W. M.

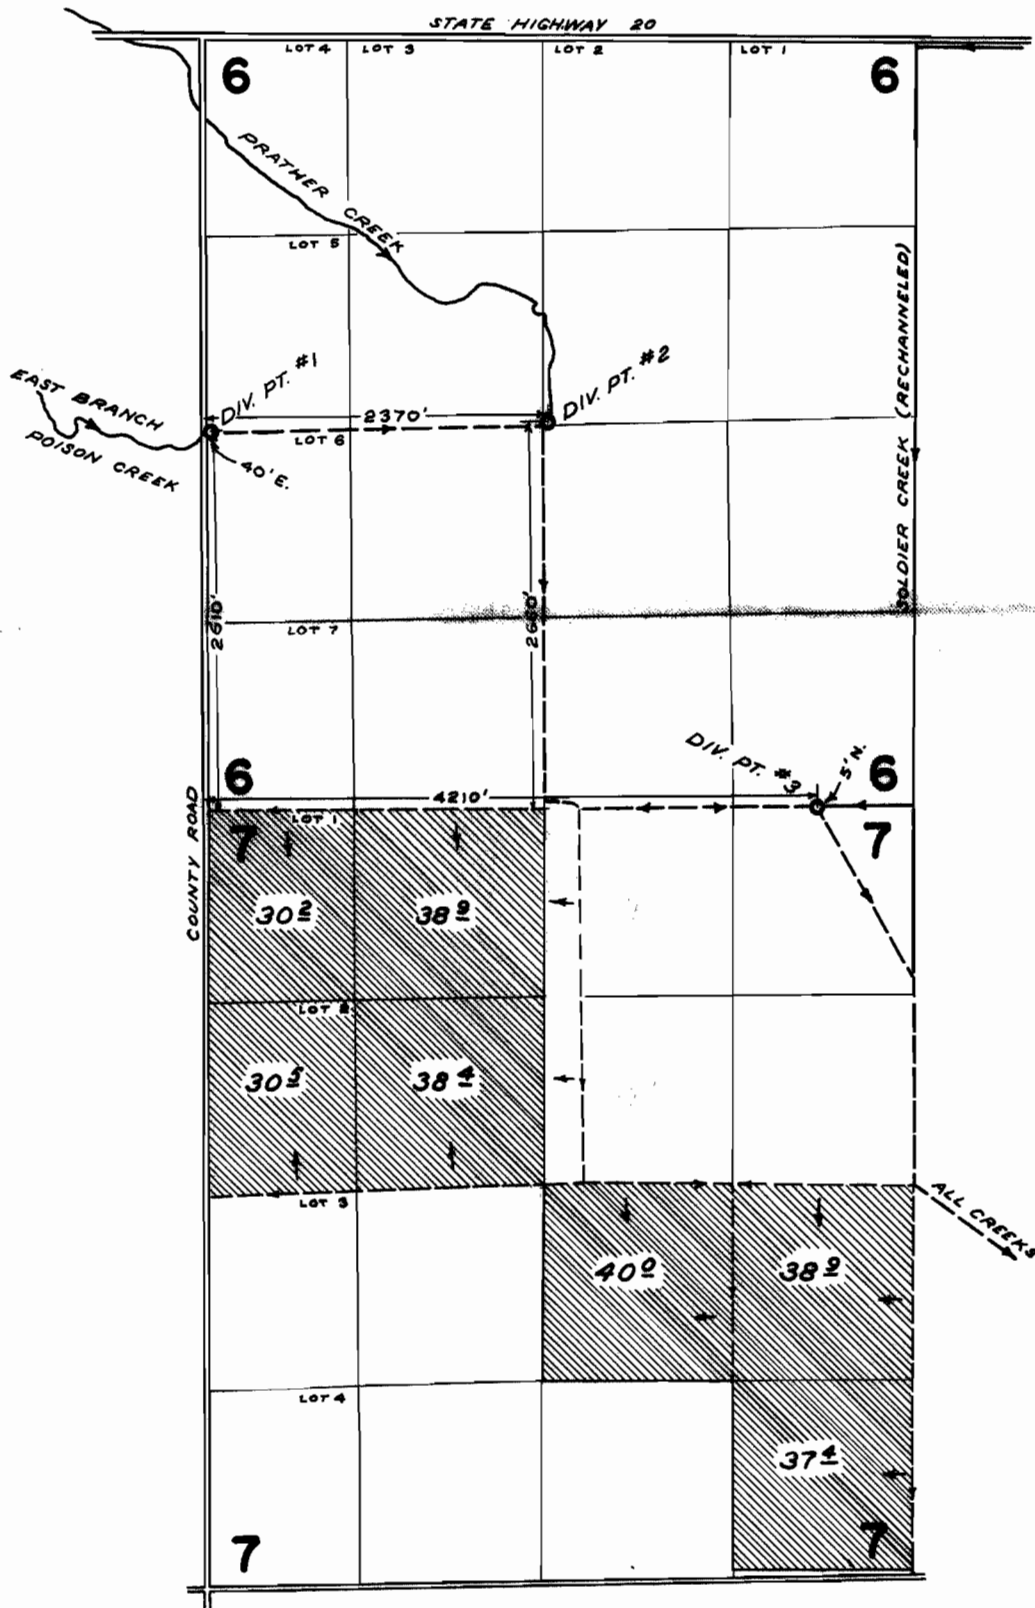

FINAL PROOF SURVEY UNDER

Application No. 37295, Permit No. 27777
IN NAME OF

HUBER RAY

Surveyed Sept. 16, 1963 by C. Baker
Sept. 20, 1965 by C. Gardner