


T. 34 S. R. 34 E. W. M.

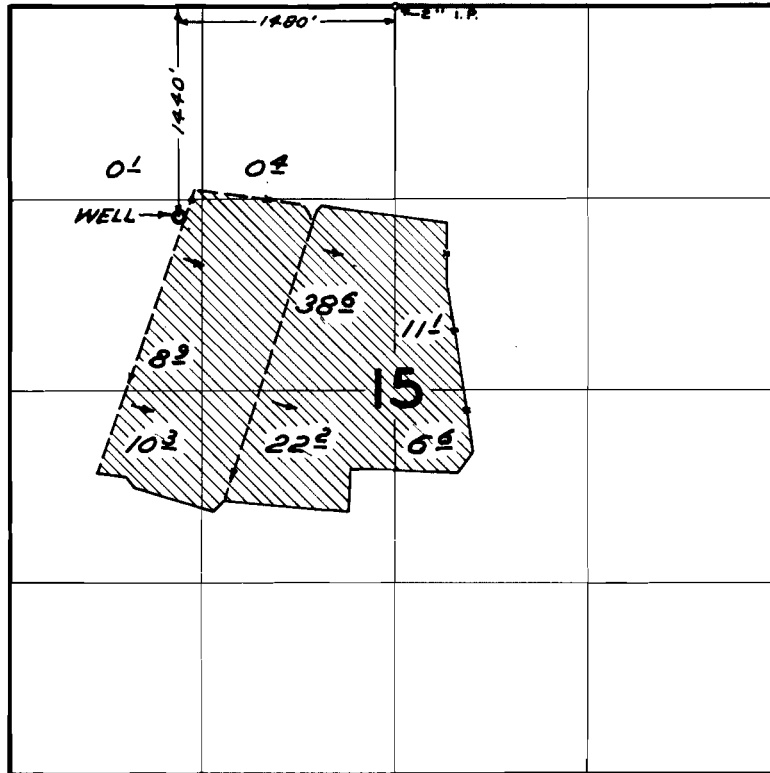

FINAL PROOF SURVEY UNDER

Application No. G-2016 Permit No. G-1855
IN NAME OF

ROBERT B. & CONSTANCE H. WILSON

Surveyed OCT. 23 1965, by R. JACKSON