


T. 39S.R.2 W.W.M.

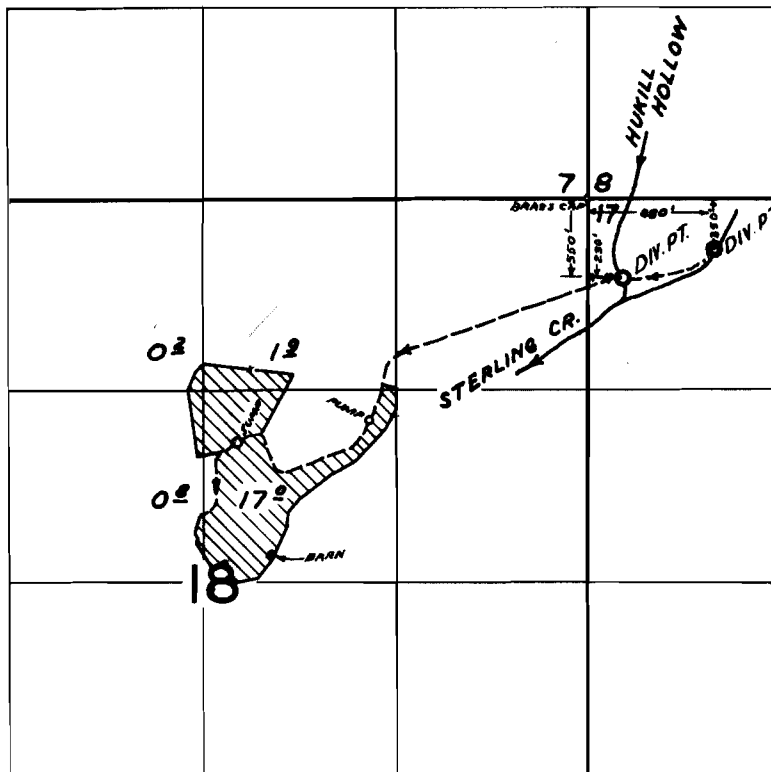

**FINAL PROOF SURVEY**  
UNDER

Application No. 33401 Permit No. 26421  
IN NAME OF

EARL M. BROWN

Surveyed JUN. 28 1965, by C. GARDNER