


T. 40 S. R. 4 W. W. M.

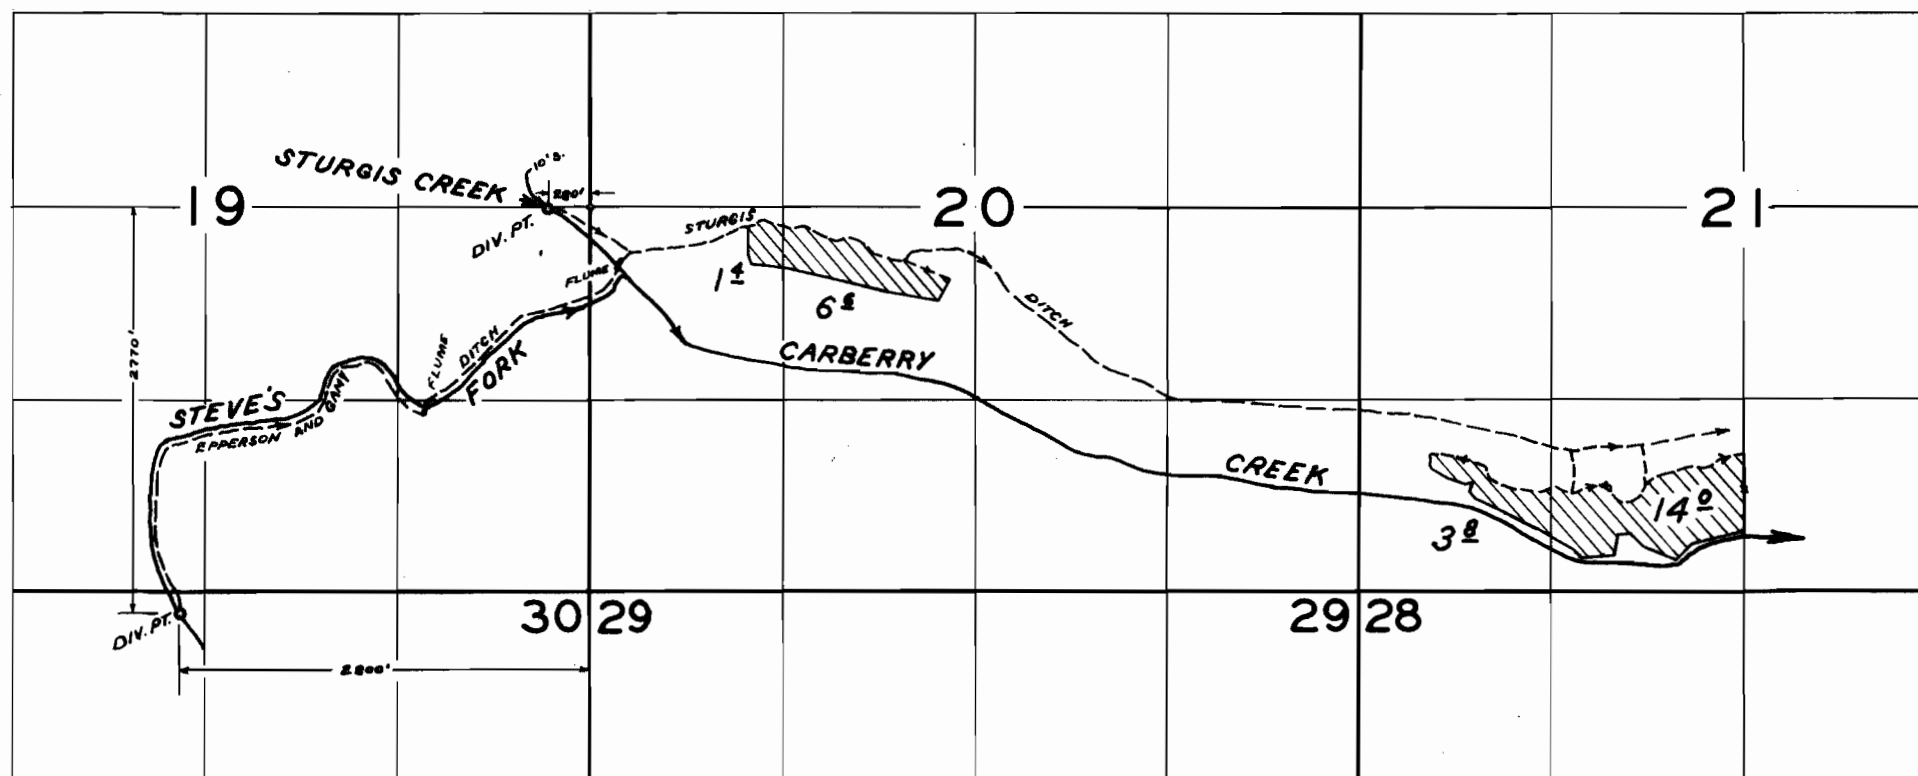

FINAL PROOF SURVEY
UNDER

APPLICATION NO. 31156 PERMIT NO. 24553

IN NAME OF
GEORGE DAWSON

SURVEYED JUN. 29, 30, 1965, BY C. GARDNER